


Section 12 Township 19 Range 13W

Well No. #1 Prosser

Company Simon Lebow et al

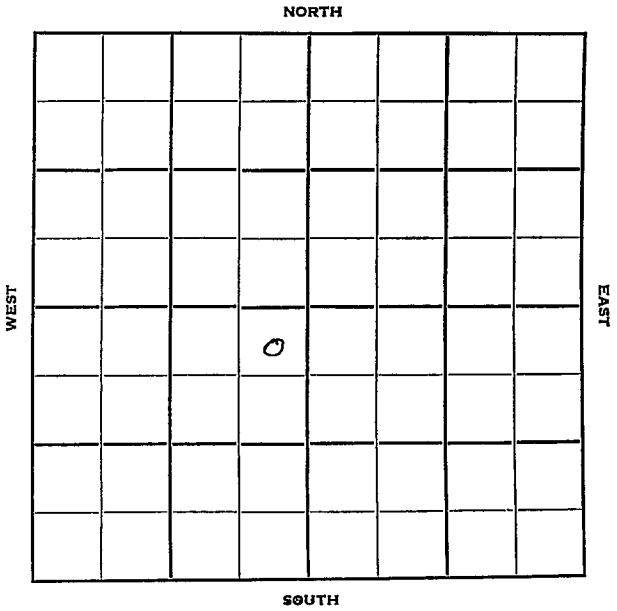

Sec. 12 Twp. 19 R. 13W

Well No. #1 Prosser Farm

Simon Lebow et al Company

Quaker Drlg. Contractor

330 Wildcat


\_\_\_\_\_ Ft. from N. Line

\_\_\_\_\_ Ft. from S. Line

330 \_\_\_\_\_ Ft. from E. Line

\_\_\_\_\_ Ft. from W. Line

NE. NE SW

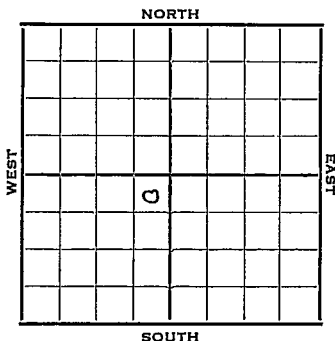

1952 Elev. 1885' REPORT

5/14 Spud 5-8-52  
8" @ 240'  
Drlg. 2820'

5/21 Heeb 3098' Br li 3202' Lans. 3218'  
DST 3221-32, 3/4 hr, 32' M 850#  
DST 3330-3426, 20 mins, 60' M  
Cong. 3460' Arb. 3470'  
DST 3471-81 25 mins, 8' VSOCM 700#  
TD 3481' 5" @ 3471 RUST

5/28 NR

6/11 NR

6/18 "

6/25 Spud 5-8-52  
D&A TD 3487  
8" @ 240 Heeb. 3098  
Br Lime 3202 Lans. 3218  
DST 3221-32 opn 3/4 hr. Rec. 32' mud  
DST 3330-3426 opn 20 min. Rec 60'  
mud Cong. 3460 Arb. 3470  
DST 3471-81 opn 25 min. Rec. 8'  
vsocm TD 3481 5" @ 3471  
GO to 3481 500 A DD 3487 SO&W  
500 A FU 1500' wtr.  
D&A

**ABANDONED**

County Barton State Kansas

Sec. 12 (Blk. Twp.) 19 (Sur. Rge.) 13W Map No.

Operator Simon Lebow et al.

Well No. 1 Farm Frosser

Elev. Location NE NE SW

FIRST REPORT									

330 Ft. From N Line SW

330 Ft. From E Line Quarter

1st. Report MAY 14 1952

Completion

Remarks

Quaker Drlg. - Contr.

Spudding Date 5-8-52

Drlg. Data Wildcat

8" @ 240 drlg. 2820

J. G. McGEHEE

