


Section 12 Township 19 Range 19 W

Well No. # 1 Shiney

Company Musgrove Pet.

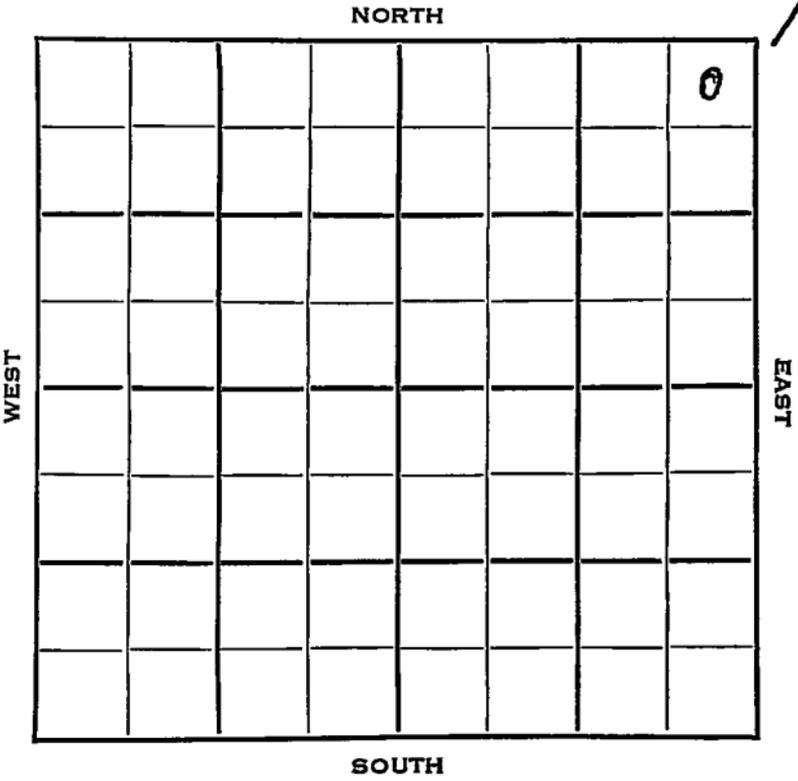

Rush

KANSAS



Sec. 12 Twp. 19 R. 19 W

Well No. # 1 Shiney Farm

Musgrove Pet. Company

Musgrove Contractor

Wildcat

330 Ft. from N. Line


_____ Ft. from S. Line

330 Ft. from E. Line

_____ Ft. from W. Line

NE NE NE

Atl., Sohio & NCRA - DHM

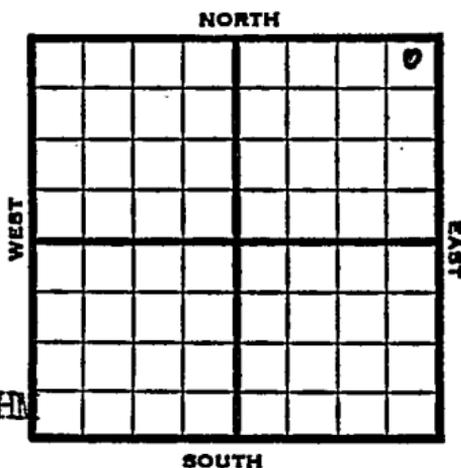

1953 Elev. 2068' REPORT

8/26

Spud 8-20-53

8" @ 943

Drlg. 2400'

9/2

Spud 8-20-53

D&A

TD 4008

8" @ 943

Top 3140, Heeb-3458, Tor 3476, Lans 3505, B KC 3786, Cong 3870, Arb.

3875

TD 4008

D&A

ABANDONED

County Rush State Kansas

Sec. 12 (Blk. 19 (Sur. 19W Map No. 19W)
(Twp.) (Rge.)

Operator Musgrove Pet.

Well No. 1 Farm Shiney

Elev. _____ Location NE NE NE

330 Ft. From N Line NE

330 Ft. From E Line Quarter

1st. Report AUG 26 1953

Completion _____

Remarks Atl., Sohio & NCRA
DHM

Musgrove - Contr.

Spudding Date 8-20-53

Drlg. Data Wildcat

8" @ 943 drlg. 2400

County Rush State Kansas

Sec. 12 (Blk. 19) (Sur. 19W) (Rge.) Map No.

Operator Musgrove Pet.

Well No. 1 Farm Shiney

Elev. 2068 Location NE NE NE

330Ft. From N Line NE

330Ft. From E Line Quarter

Ist. Report

Completion SEP 2 1953

Remarks Wildcat

Musgrove - Contr.

Spudding Date 8-20-53

Drlg. Data D & A TD 4008

8" @ 943 Top. 3140 Heeb. 3458

Tor. 3476 Lans. 3505 B KC 3786

Cong. 3870 Arb. 3875 TD 4008

D & A