

KANSAS DRILLERS LOG

S. 25 T. 19 R. 13 ^N/_W
 Loc. C S2 SW NW
 County Barton

API No. 15 — County — OWWO Number

Operator
Nadel & Gussman

Address
3232 First National Tower Tulsa, Oklahoma 74103


Well No. #6 Lease Name Wood OWWO

Footage Location
330 feet from (S) line 660 feet from (W) line

Principal Contractor Duke Drilling Geologist _____

Spud Date _____ Total Depth 3677' P.B.T.D. _____

Date Completed 3-21-76 Oil Purchaser _____

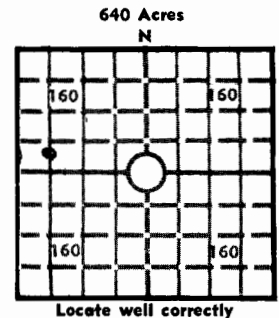

Elev.: Gr. _____
 DF _____ KB 1841'

CASING RECORD

Report of all strings set — surface, intermediate, production, etc.

Purpose of string	Size hole drilled	Size casing set (in O.D.)	Weight lbs/ft.	Setting depth	Type cement	Sacks	Type and percent additives
Surface		8-5/8"		380'	Reg.	250	
Disposal Csq.	OWWO	5-1/2"	14#	3596'	60/40 Poz	225	

LINER RECORD

PERFORATION RECORD

Top, ft.	Bottom, ft.	Sacks cement	Shots per ft.	Size & type	Depth interval

Size	Setting depth	Packer set at
2-1/2"	3500'	3500'

ACID, FRACTURE, SHOT, CEMENT SQUEEZE RECORD

Amount and kind of material used	Depth interval treated

INITIAL PRODUCTION

Date of first production _____ Producing method (flowing, pumping, gas lift, etc.) SWDW

RATE OF PRODUCTION PER 24 HOURS	Oil _____ bbls.	Gas _____ MCF	Water _____ bbls.	Gas-oil ratio _____ CFPB
---------------------------------	-----------------	---------------	-------------------	--------------------------

Disposition of gas (vented, used on lease or sold) _____ Producing interval (s) _____

INSTRUCTIONS: As provided in KCC Rule 82-2-125, within 90 days after completion of a well, one completed copy of this Drillers Log shall be transmitted to the State Geological Survey of Kansas, 4150 Monroe Street, Wichita, Kansas 67209. Copies of this form are available from the Conservation Division, State Corporation Commission, 3830 So. Meridian (P.O. Box 17027), Wichita, Kansas 66217. Phone AC 316-522-2206. If confidential custody is desired, please note Rule 82-2-125. Drillers Logs will be on open file in the Oil and Gas Division, State Geological Survey of Kansas, Lawrence, Kansas 66044.

operator

DESIGNATE TYPE OF COMP.: OIL, GAS, DRY HOLE, SWDW ETC.:

NADEL AND GUSSMAN

Well No.

6

Lease Name

Wood

S 25 T 19 R 13 E W

WELL LOG

Show all important zones of porosity and contents thereof; cored intervals, and all drill-stem tests, including depth interval tested, cushion used, time tool open, flowing and shut-in pressures, and recoveries.

SHOW GEOLOGICAL MARKERS, LOGS RUN, OR OTHER DESCRIPTIVE INFORMATION.

FORMATION DESCRIPTION, CONTENTS, ETC.

TOP

BOTTOM

NAME

DEPTH

SEE ATTACHED LOG:

This was old dry hole that was washed down for Disposal. Original TD was 3541' in the Arbuckle, was drilled deeper to 3677'

USE ADDITIONAL SHEETS, IF NECESSARY, TO COMPLETE WELL RECORD.

Date Received

M. R. Taylor

M. R. Taylor

Signature

Manager of Production

Title

August 13, 1976

Date

11397E