


KANSAS

FORM 51 5M PETROL

Section 13 Township 19 Range 12W

Well No. 1 Hammeke

Company Lion Oil Ref.

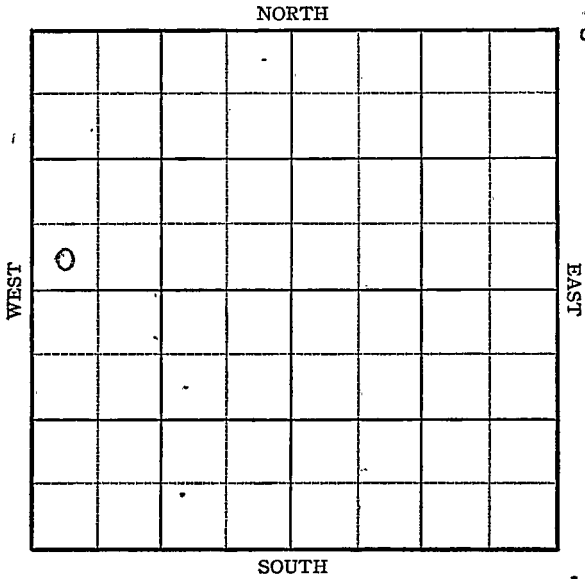

Sec. 13 Twp. 19 R. 12W

Well No. #1 Hammeke Farm

Lion Oil Ref. Company


Wildcat

_____ Ft. from N. Line

330 Ft. from S. Line

_____ Ft. from E. Line

330 Ft. from W. Line

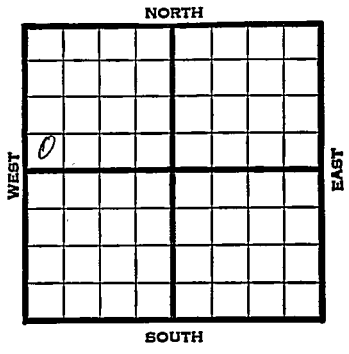

SW NW

1-945 Elev. 1821 REPORT

7/11 Derrick
 7/19 8" @ 266
 Drlg. 1825
 7/26 Lans 3123
 Arb. 3376
 TD 3382 Sat.
 Run csg.

8/8 Arb. 3376
 5" @ 3377'
 T.D. 3450'
 Water

ABANDONED

Pool Name Wildcat

KANSAS

Kansas

Map No. 116 Sec. 13 Twp. 19 R. 12W

Well No. 1 Hammeke

Lion Oil Ref. Company

ABANDONED Contractor

SW NW

E 1/8 21
SECTION PLAT

 Ft. from N. Line

330 Ft. from S. Line

 Ft. from E. Line

330 Ft. from W. Line

Barton County

Location

Rig up

Drilling and Remarks:

Ar 83376
5" @ 3377
Water

RECORD

Cased in., ft.

Sand

Gas

Oil

Total Depth 845 1/2

PRODUCTION

1st 24 hrs. Nat.

1st 24 hrs. after shot

Gas Cu. Ft.

Dry Hole

Abandoned

Date

AUG 8 1945 19

S. J. LEWIS Scout