
FORM 51 5M PETROL KANSAS

Barton

Section 13 Township 19 Range 11-W

Well No. #3 Eberhardt

Company Stanolind

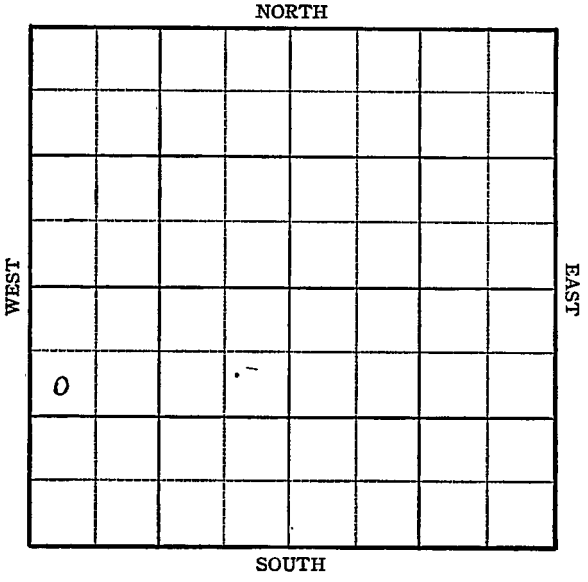

FORM 252-A
5M 12-45 PETROL

KANSAS Barton County ✓

Sec. 13 Twp. 19 R. 11W

Well No. #3 Eberhardt Farm

Stanolind Company

Silica


990 Ft. from N. Line

Ft. from S. Line

Ft. from E. Line

330 Ft. from W. Line

SW NW SW

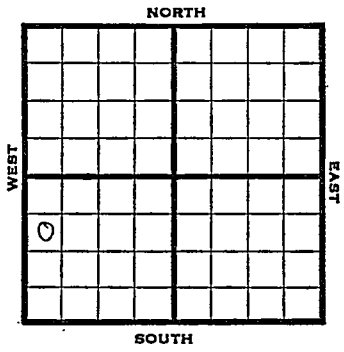

1946	Elev. 1776 REPORT
3/13	Location
3/21	Anhy 521' 9" - 525' Drlg. 1513'
3/28	Drlg. 3029'
4/4	Lans. 3032 Arb. 3317-3325 TD 3325 6" @ 3317 RUST
4/10	2000 acid No help Drlg 3350
4/17	Arb. 3317 6" @ 3317 2000 acid. TD 3353 Pump 35 Pot. Grav. 42.0

COMPLETED

FORM 25 200 BKS. 1 44 PETROL

KANSAS Kansas Pool Name Silica

Map No. 26 Sec. 13 Twp. 19 R. 11W

Well No. 3 Eberhardt

Stanolind Company

FIRST REPORT Contractor

SW NW SW


990 Ft. from N. Line

Ft. from S. Line

Ft. from E. Line

330 Ft. from W. Line

SECTION PLAT

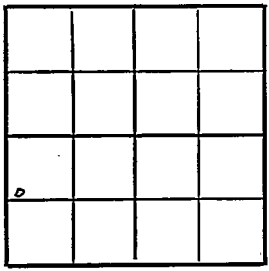

Barton County

Location X

Rig up

Drilling and Remarks:

RECORD

Cased in., ft.

Sand

Gas

Oil

Total Depth

PRODUCTION

1st 24 hrs. Nat.

1st 24 hrs. after shot

Gas Cu. Ft.

Dry Hole

Abandoned

Date

MAR 13 1946 19 S. J. LEWIS Scout

FORM 26 200 BKS. 2-44 PETROL

KANSAS Kansas Pool Name Silica

Map No. 44 Sec. 13 Twp. 19 R. 11W

Well No. 3 Eberhardt

Stanolind Company

COMPLETED Contractor

SW NW SW

E 1/2 1996


SECTION PLAT

990 Ft. from N. Line

Ft. from S. Line

Ft. from E. Line

330 Ft. from W. Line

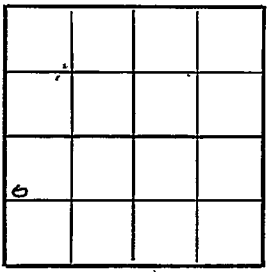

Barton County

Location

Rig up

Drilling and Remarks:

Cr 3317
6" @ 3317.
200 sand
Pump & Rod

42 - 42

RECORD

Cased in., ft.

Sand

Gas

Oil

Total Depth 3365

PRODUCTION

1st 24 hrs. Nat.

1st 24 hrs. after shot

Gas Cu. Ft.

Dry Hole

Abandoned

Date

APR 17 1946 19 S. J. LEWIS Scout