


Section 13 Township 19 Range 11W

Well No. #1 Johanning

Company Derby Oil

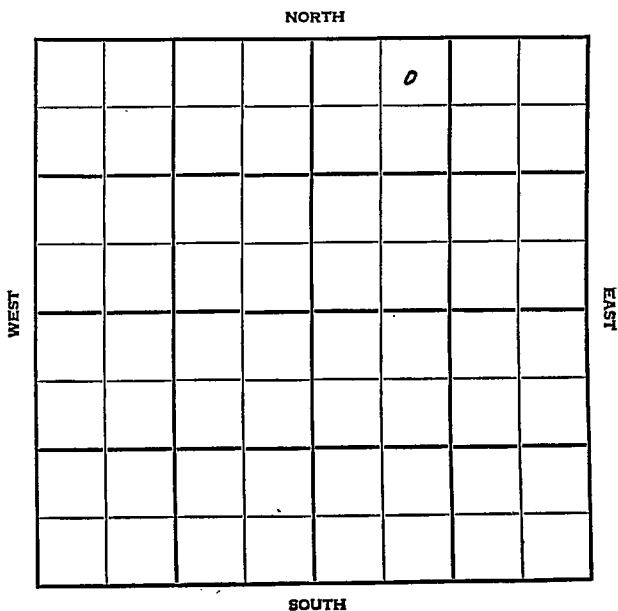

SEC.	TWP.	R.
13	19	11W

WELL NO.

#1 Johannig

FARM

COMPANY

Derby Oil

CONTRACTOR

G-M-R

Eberhardt Pool

NORTH

330

Ft. from N. Line

				0	

Ft. from S. Line

Ft. from E. Line

990

Ft. from W. Line

NE NW NE

SOUTH

1954

ELEVATION

1777'

REPORT

10/13  
11/23

Location

Spud 10-15-54 - Oil Well

TD 3380'

8-5/8" @ 225'

Heeb 2910', Br lime 3029', Lans 3050',

Cong. 3342', Arb. 3367'

DST 3369-80', opn 1 hr., rec. 520' oil  
840#

TD 3380'

5" @ 3369'

CO to 3380'

S/2.76 boph 5 boph 12% wtr.

PB 3376'

S/10.32 bf 2% wtr.

P/43 bo 12% wtr.

P/41 bo 2% wtr.

C omp. 44 bopd 4% wtr.

**COMPLETED**



