


Rice

KANSAS

Section 13 Township 19 Range 10W  
Well No. #6 Emerich (Emerick)  
Company Carl Lebsack Atlantic

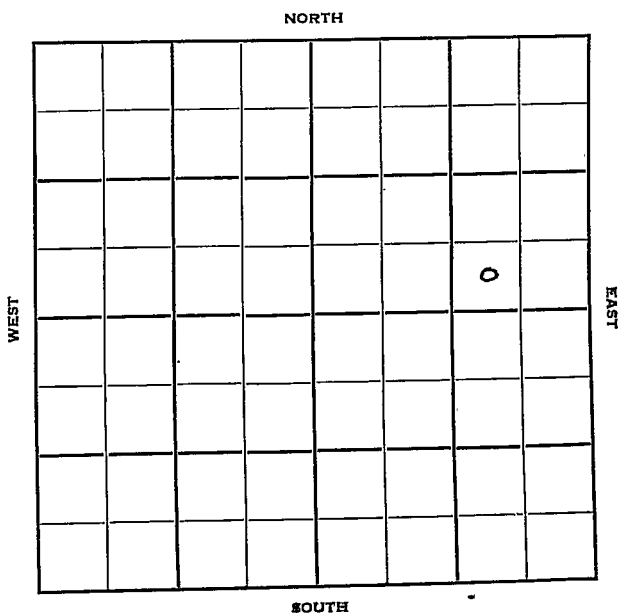

O. W. D. D

Rice

KANSAS 10W

Sec. 13 Twp. 19 R. 10W

Well No. #6 Emerich Farm

~~Carl Lebsack~~ Atlantic Company

Keyes Drlg. Contractor

Doran Pool


Ft. from N. Line

NORTH

440' Ft. from S. Line

990' Ft. from E. Line

Ft. from W. Line

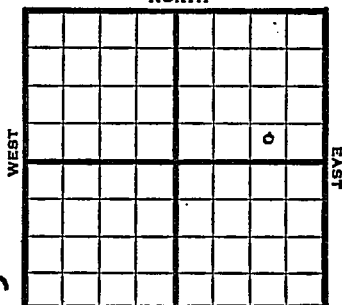

-SW SE NE

O. W. D. D

SOUTH

1950

Elev. 1740' REPORT

4/5

Spud 4-1-50

8" @ 170'

Anhy 400'

Drlg. 1620'

7/5

8" @ 170'

Anhy 400'

Heeb 2793'

Br. Lime 2920'

Lans. 2936'

Cong. 3250'

Arb. 3283-85'

TD 3392

ABANDONED

O. W. D. D

1950

8/2

Lans 2936

Cong 3250

Arb 3283

5" @ 3285

OTD 3392

8/30

Drlg @ 3456

Lans 2936

Cong 3250

Reagan 3735

Granite 3740

TD 3802 PB 3388

CO to 3802 3000 A Input 200 bwph

Comp for SWD

Completed

COMPLETED

Doran Pool

Kansas

Flow 12.500 GPM  
 Map No. 13 Sec. 13 Twp. 19 R. 10W

Well No. 6 Emerich

Carl Lebsack Company

Keyes Drlg. Contractor

El. 1740

SECTION PLAT

SW SE NE



Ft. from N. Line

440 Ft. from S. Line

990 Ft. from E. Line

Ft. from W. Line

Rice County

Location

Rig up

Drilling and Remarks:

Spud 4-1-50

8" @ 170

Anhy 400

drlg. 1620

## RECORD

Cased \_\_\_\_\_ in., \_\_\_\_\_ ft.

Sand \_\_\_\_\_

Gas \_\_\_\_\_

Oil \_\_\_\_\_

Total Depth \_\_\_\_\_

## PRODUCTION

1st 24 hrs. Nat. \_\_\_\_\_

1st 24 hrs. after shot \_\_\_\_\_

Gas \_\_\_\_\_ Cu. Ft.

Dry Hole \_\_\_\_\_

Abandoned \_\_\_\_\_

Date


APR 5 1950 19

J. E. TYRA

Scout

KansasMap No. \_\_\_\_\_ Sec. 13 Twp. 19 R. 10WWell No. 6 Emerick\_\_\_\_\_  
Carl Lebsack \_\_\_\_\_ Company\_\_\_\_\_  
Contractor

SW SE NE

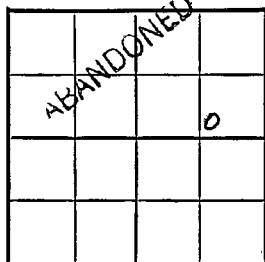E1. 1740  
SECTION PLAT\_\_\_\_\_  
Ft. from N. Line440 Ft. from S. Line990 Ft. from E. Line\_\_\_\_\_  
Ft. from W. Line\_\_\_\_\_  
Rice County

Location \_\_\_\_\_

Rig up \_\_\_\_\_

Drilling and Remarks:

8" ( 170

Anhy 400

Heeb. 2793

Br. lime 2920

Lans. 2936.

Cong. 3250

Arb. 3283-85

## RECORD

Cased \_\_\_\_\_ in., \_\_\_\_\_ ft.

Sand \_\_\_\_\_

Gas \_\_\_\_\_

Oil \_\_\_\_\_

Total Depth 3392

## PRODUCTION

1st 24 hrs. Nat. \_\_\_\_\_

1st 24 hrs. after shot \_\_\_\_\_

Gas \_\_\_\_\_ Cu. Ft.

Dry Hole \_\_\_\_\_


Abandoned \_\_\_\_\_

Date

JUL 5 1950 19 J E. TYRA Scout

Map No. \_\_\_\_\_ Sec. 13 Twp. 19 R. 10WWell No. 6 EmerickAtlantic (was Lebsack) Company\_\_\_\_\_  
Contractor

SW SE NE

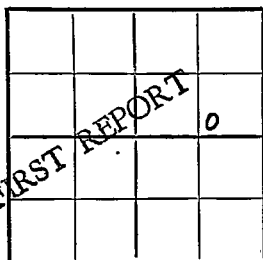E1. 1740  
SECTION PLAT\_\_\_\_\_  
Ft. from N. Line440 Ft. from S. Line990 Ft. from E. Line\_\_\_\_\_  
Ft. from W. LineRice County

Location \_\_\_\_\_

Rig up \_\_\_\_\_

Drilling and Remarks:

Lans. 2936

Cong. 3250

Arb. 3283

5" @ 3285

OTD 3392

drlg. @ 3456

## RECORD

Cased \_\_\_\_\_ in., \_\_\_\_\_ ft.

Sand \_\_\_\_\_

Gas \_\_\_\_\_

Oil \_\_\_\_\_

Total Depth \_\_\_\_\_

## PRODUCTION

1st 24 hrs. Nat. \_\_\_\_\_

1st 24 hrs. after shot \_\_\_\_\_

Gas \_\_\_\_\_ Cu. Ft.

Dry Hole \_\_\_\_\_

Abandoned \_\_\_\_\_

Date

AUG 2 1950J. E. TYRA Scout

County Rice State Kansas  
 Sec. 13 (Blk. 19 (Sur. 10W Map No.  
 (Twp.) (Rge.)

Operator Atlantic

Well No. 6 Farm Emerich

Elev. 1740 Location SW SE NE

|  |  |  |  |  |  |  |  |
|--|--|--|--|--|--|--|--|
|  |  |  |  |  |  |  |  |
|  |  |  |  |  |  |  |  |
440 Ft. From S Line NE

990 Ft. From E Line Quarter

1st. Report

AUG 30 1950

Completion

Remarks OWDD for SWD

Spudding Date

Drig. Data

Lans. 2936 Cong. 3250 Arb. 3283

5" @ 3285 OTD 3392 Reagan 3735

Granite 3740 TD 3802 PB 3388

CO to 3802 3000 A Input 200 bwph

Comp for SWD

J. E. TYRA