


Section 13 Township 19 Range 10-W

Well No. #1, Browning

Company Keyes Drlg.

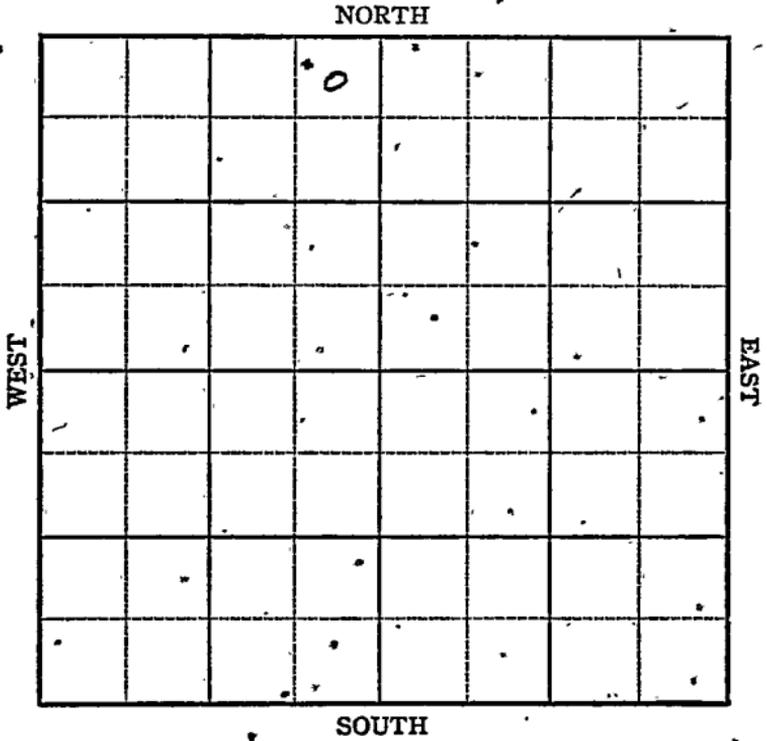

KANSAS

Rice

Sec. 13 Twp. 19 R. 10-W

Well No. #1, Browning Farm

Keyes Drlg. Company


Silica Pool

330' Ft. from N. Line

_____ Ft. from S. Line

330' Ft. from E. Line

_____ Ft. from W. Line

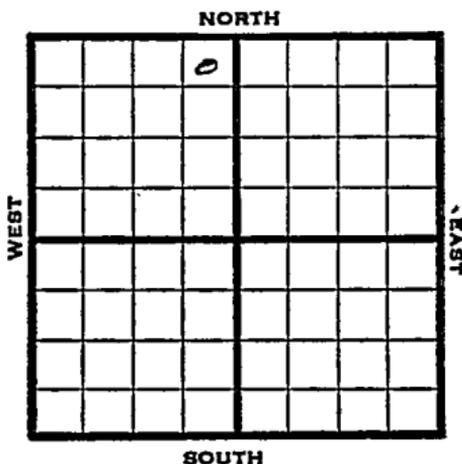

NE NW

1947

Elev. 1747

REPORT

1/22

8" @ 150'

Drlg. 1330'

2/12

Arb. 3280

5" @ 3281'

500 Acid

Pump 459 Pot

Grav. 42.3

TD 3287'

COMPLETED

Kansas
KANSAS


Silica Pool

Map No. 46 Sec. 13 Twp. 19 R. 10WWell No. 1 BrowningKeyes Drlg. CompanyFIRST REPORT Contractor

NE NW

330 Ft. from N. Line Ft. from S. Line330 Ft. from E. Line Ft. from W. Line

SECTION PLAT

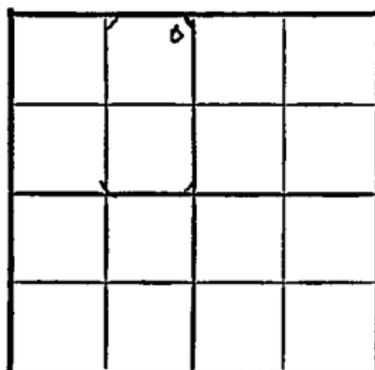

Rice County

Location _____

Rig up _____

Drilling and Remarks:

8" @ 150

drlg. 1330

RECORD

Cased _____ in. _____ ft.

~~Sand~~ _____

Gas _____

Oil _____

Total Depth _____

PRODUCTION

1st 24 hrs. Nat. _____

1st 24 hrs. after shot _____

Gas _____ Cu. Ft.

Dry Hole _____

Abandoned _____

Date

JAN 22 1947 19

S. J. LEWIS Scout

Map No. 46 Sec. 13 Twp. 19 R. 10WWell No. 1 Browning

Keyes Drlg. _____ Company

COMPLETE

Contractor

NE NW

E11747
SECTION PLAT330 Ft. from N. Line

_____ Ft. from S. Line

330 Ft. from E. Line

_____ Ft. from W. Line

		0	

Rice County

Location _____

Rig up _____

Drilling and Remarks:


RECORD

Cased _____ in., _____ ft.

Sand _____

Gas _____

Oil _____

Total Depth 43280

PRODUCTION

1st 24 hrs. Nat. _____

1st 24 hrs. after shot _____

Gas _____ Cu. Ft.

Dry Hole _____

Abandoned _____

Date

FEB 12 1947 19S. J. LEWIS Scout