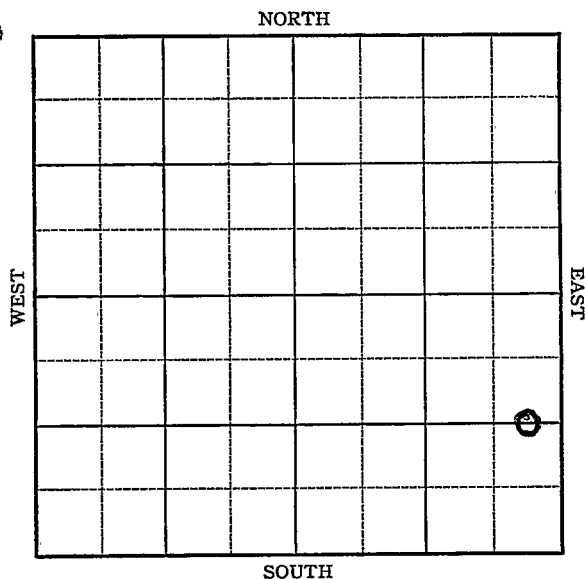


Rice

KANSAS

Section 13 Township 19 Range 10-WWell No. 2 - DoranCompany Atlantic

Sec. 13 Twp. 19 R. 10 th W

Well No. #2 Doran Farm

Atlantic

Company

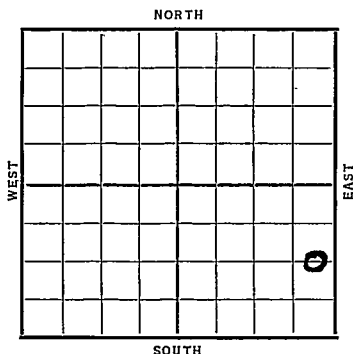
Ft. from N. Line

1320 Ft. from S. Line

330 Ft. from E. Line

Ft. from W. Line

Special

[illegible]

7/19--Siliceous 3289-99 Filled up 166 bbls.
 in 10 hours Acidized 1000 gallons
 Had small increase in oil and gas
 Drilled deeper T.D. 3301
 Reacidized 2000 gallons acid
 Swab down Let fill up
 Swabbed 20 bbls. 1st $1\frac{1}{2}$ hours
 Filled up at rate of 14 bbls. per hour
 Reacidized 4000 gallons acid
 Waiting on acid (Tel)

7/23 Pumped 396 oil & 190 water in
 8 hrs.

7/30 " " " " "

8/4 7" @ 3290'.

Sil. 3289'.

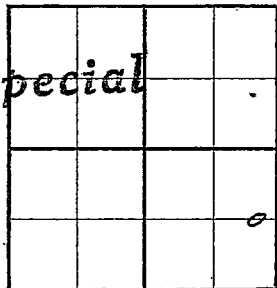
T.D. 3301'.

Total of 6000 acid.

Pumped 326 oil 190 water in 7 hrs. & 40
 Min.

Pot. 874 bbls.

COMPLETED

Rice **KANSAS**Map No. _____ Sec. 13 Twp. 19 R 10 ^WWell No. 2 - DoranAtlantic Company_____
Contractor**FIRST REPORT****SECTION PLAT**_____
Ft. from N. Line1320 Ft. from S. Line330 Ft. from E. Line_____
Ft. from W. Line**Special**

Location _____

Rig up _____

Drilling and Remarks:

*BRR***RECORD**

Cased _____ in., _____ ft.

Sand _____

Gas _____

Oil _____

Total Depth _____

PRODUCTION

1st 24 hrs. Nat. _____

1st 24 hrs. after shot _____

Gas _____ Cu. Ft.

Dry Hole _____

Abandoned _____

Date

MAY 26 1931

19

H. D. Hatfield

Scout

Returned

Cards

Tracing

France Map

Scarborough Map

Moody Map

Scarborough Plat Book

Moody Plat Book

Rice **KANSAS**Map No. _____ Sec. 13 Twp. 19 R. 10WWell No. 2 - Doranatlantic Company

Contractor _____

COMPLETED**SECTION PLAT**

			0

_____ Ft. from N. Line

1320 Ft. from S. Line330 Ft. from E. Line

_____ Ft. from W. Line

Location _____

Rig up _____

Drilling and Remarks:

Total of 6000 andPumped 326 oil
190 water
in 7 hrs & 40 minPot. - 874**RECORD**Cased 7 in. 3290 ft.Sand 511 3289.

Gas _____

Oil _____

Total Depth 3301**PRODUCTION**

1st 24 hrs. Nat. _____

1st 24 hrs. after shot _____

Gas _____ Cu. Ft.

Dry Hole _____

Abandoned _____

Date

AUG 4 - 1937 19H. D. Hatfield Scout

1
John

Returned	<i>Paul</i>
Cards	<i>John</i>
Tracing	<i>John</i>
France Map	<i>John</i>
Scarborough Map	<i>John</i>
Moody Map	<i>John</i>
Scarborough Plat Book	
Moody Flat Book	