

KANSAS

Section 13 Township 19 Range 10W

Well No. #5 Doran

Company Carl Lebsack

WEST

EAST

SOUTH

Rice

SEC.	TWP.	R.
13	19	KANSAS 10W ✓

WELL NO.

#5 Doran

FARM

COMPANY

Carl Lebsack

CONTRACTOR

Isern Drlg.

Chase-Silica Pool


NORTH

Ft. from N. Line

Ft. from S. Line

Ft. from E. Line

Ft. from W. Line

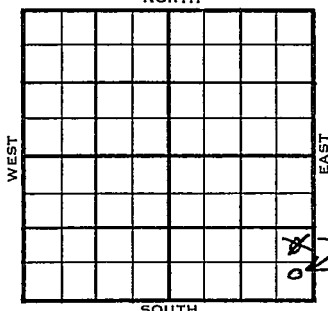

SE

NE SE SE

1954

ELEVATION

1744'

REPORT

3/10

Spud 3-6-54

8" @ 170'

WOC.

3/17

Heeb 2788', Br li 2917', Lans 2938'

DST 3008-35', 1 hr., 30' M Off

Drlg. 3250'

3/24

Spud 3-6-54 D & A TD 3322

8" @ 170 Heeb 2788 Br line 2917

Lans. 2938

DST 3008-35 open 1 hr rec 30' mud Off

Cong. 3257

DST 3279-86 open 1 hr rec 35' SOCM

Off Arb. 3289

DST 3290-94 open 1 hr rec 20' mud Off

TD 3322 D & A

ABANDONED

J. G. MCGHEE

Kansas

Map No. _____ Sec. 13 Twp. 19 R. 10WWell No. 5 Doran_____
Carl Lebsack Company_____
CORRECTION Contractor

SE SE SE

SECTION PLAT

Ft. from N. Line420 Ft. from S. Line330 Ft. from E. Line_____
Ft. from W. Line

			o

Rice County

Location _____

Rig up _____

Drilling and Remarks:

Reported

NE SE SE

RECORD

Cased _____ in., _____ ft.

Sand _____

Gas _____

Oil _____

Total Depth _____

PRODUCTION

1st 24 hrs. Nat. _____

1st 24 hrs. after shot _____

Gas _____ Cu. Ft.

Dry Hole _____


Abandoned _____

Date

MAR 24 1939J. G. McGEHEE

Scout

County Rice State Kansas
 Sec. 13 (Blk. 19 (Sur. 10W Map No.
 (Twp.) (Rge.)
 Operator Carl Lebsack
 Well No. 5 Farm Doran
 Elev. 1744 Location SE SE SE

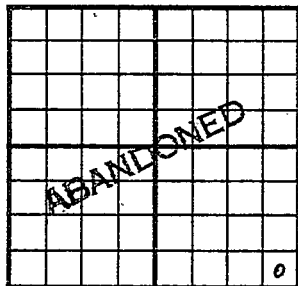

420 Ft. From S Line SE
 330 Ft. From E Line Quarter

1st. Report

Completion MAR 24 1954

Remarks Chase-Silica Pool

Isern Drlg. - Contr.

Spudding Date 3-6-54

Drlg. Data D & A TD 3322

8" @ 170 Heeb. 2788 Br. lime 2917

Lans. 2938 DST 3008-35 open 1 hr.

Rec. 30' mud 0# Cong. 3257 DST 3279-

86 open 1 hr. Rec. 35' socm 0#

Arb. 3289 DST 3290-94 open 1 hr.

Rec. 20' mud 0# TD 3322

D & A

J. G. McGEHEE