


Section 13 Township 19 Range 10W

Well No. #3 Dorran (Dorran)

Company Carl Lebsack ?

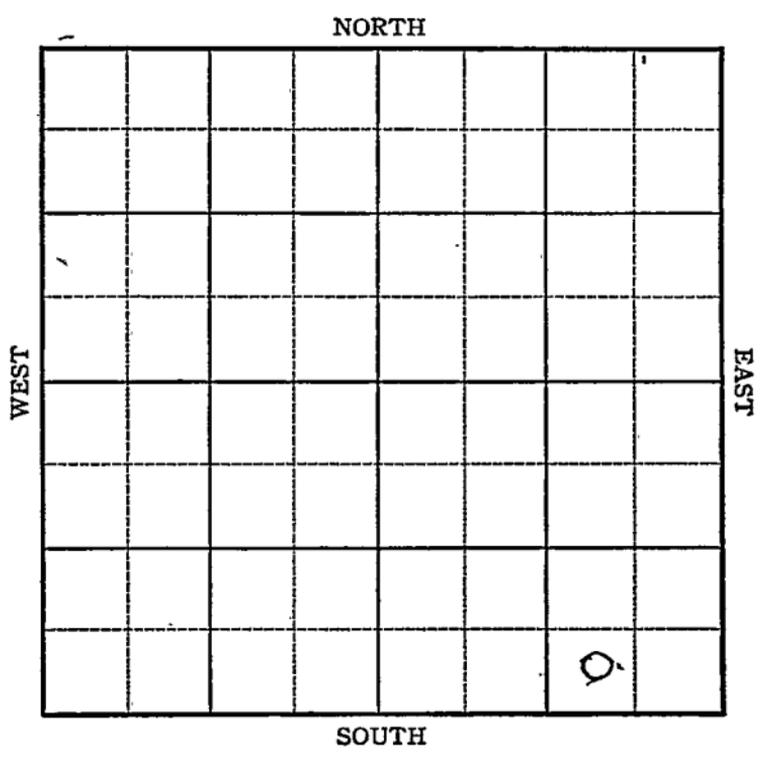

KANSAS

Rice County

Sec. 13 Twp. 19 R. 10W

Well No. #3 Dorran Farm

Carl Lebsack Company


Silica

_____ Ft. from N. Line

330 Ft. from S. Line

_____ Ft. from E. Line

990 Ft. from W. Line

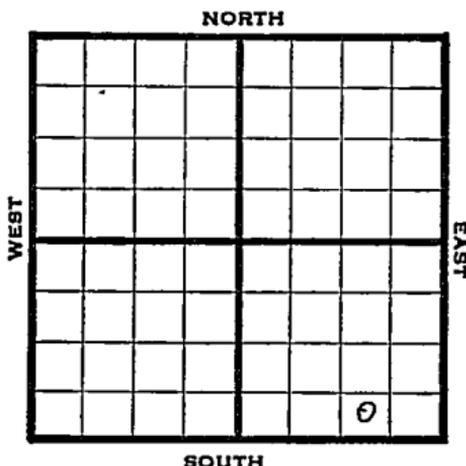

SW SE SE

1946

1743

REPORT

6/26

SH

7/3

8" @ 170'

Drlg. 2723'

7/9

"

7/16

"

7/23

Lans 2943

Arb 3282

5" @ 3282

TD 3285, 2800' oil

7/30

"

"

8/6

"

"

8/13

Swb 5 oil PH 5 hrs

8/21

Arb. 3282

5" @ 3282

TD 3285'

Pump 179 oil plus 9% Wtr. Pot.

Grav. 42.0

COMPLETED

