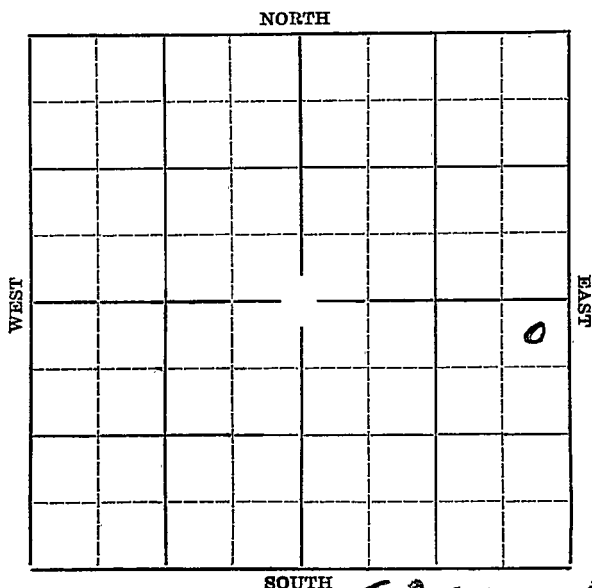


KANSAS


Rice

Form 51-5M-4-36-Palace

Section 13 Township 19 Range 10-WWell Number #1-DoranCompany John Stark et alSPECIAL
$$\begin{array}{r} 3338 \\ 3291 \\ \hline 47 \end{array}$$
$$\begin{array}{r} 3291 \\ 47 \\ \hline 3338 \end{array}$$

Map No. KANSAS Sec. 13 Twp. 19 R. 10WWell No. #1 Doran FarmJohn Stark et al Company330' Ft. from N. Line Ft. from S. Line330' Ft. from E. Line Ft. from W. Line

Elev. 1757

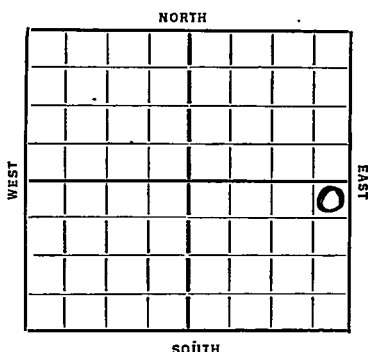

1956	REPORT
7/29	Location
8/6	--
8/13	Rig and tools.
8/20	Spud.
8/27	15" @ 117'. 12" @ 425'. Salt 905'. Drlg. 1040'.
9/3	10" @ 1700'. Shut down.
9/24	Top Siliceous 3291
	Small show oil 3300
	From 3309-10 1200 feet oil in 6 hours
	Will run pipe (Tel)
10/1	Siliceous 3291'. Drlg. 3311'. 1600 feet of oil in hole.
10/8	T.D. Pump 194 bbls natural.
10/15	1000 gallons of acid. No test.
10/21	36-Sil. 3291'.
	T.D. 3311'.
	1000 gallons of acid.
	Potential 1366 bbls. 3% water.
	COMPLETED

KANSAS

Map No. 46 Sec. 13 Twp. 19 R. 10W

Well No. 1 Moran

John Stark & Co Company
Contractor

SECTION PLAT

330 Ft. from N. Line

_____ Ft. from S. Line

330 Ft. from E. Line

_____ Ft. from W. Line

			0

COMPLETED

Location _____

Rig up _____

Drilling and Remarks:

Sic 63291
1000 acid
Potential 1366
3% water

RECORD

Cased _____ in., _____ ft.

Sand _____

Gas _____

Oil _____

Total Depth 3311

PRODUCTION

1st 24 hrs. Nat. _____

1st 24 hrs. after shot _____

Gas _____ Cu. Ft.

Dry Hole _____

Abandoned _____

Date

OCT 21 1936 19

S. J. LEWIS

Scout

KANSAS

Map No. 46 Sec. 13 Twp. 19 R. 10WWell No. 1 MoranJohn Stark & Co Company
Contractor

SPECIAL

SECTION PLAT

			0

320 Ft. from N. Line

_____ Ft. from S. Line

330 Ft. from E. Line

_____ Ft. from W. Line

FIRST REPORT

Location ✓

Rig up _____

Drilling and Remarks:

RECORD

Cased _____ in., _____ ft.

Sand _____

Gas _____

Oil _____

Total Depth _____

PRODUCTION

1st 24 hrs. Nat. _____

1st 24 hrs. after shot _____

Gas _____ Cu. Ft.

Dry Hole _____

Abandoned _____

Date _____

JUL 29 1936 19

S. J. LEWIS Scout