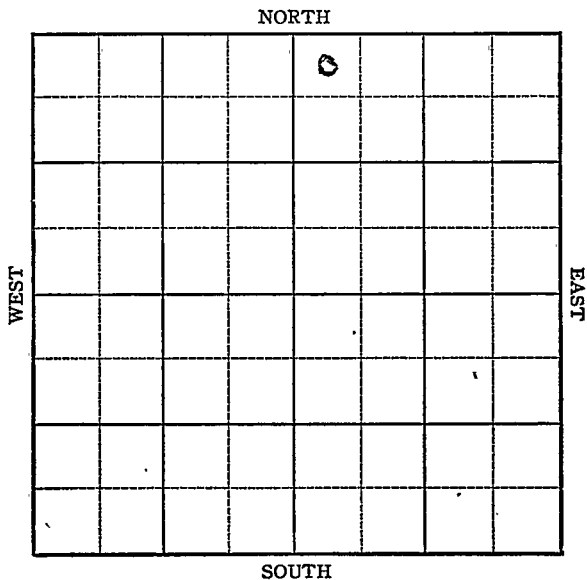


KANSAS

Rice county

FORM 51 5M 6-46 PETROL

Section 13 Township 19 Range 10-WWell No. #2, EmerickCompany Lebsack etal

KANSAS

Rice

Sec. 13 Twp. 19 R. 10W

Well No. 2 Emerick Farm

Lebsack et al Company


Silica Pool

330 Ft. from N. Line

         Ft. from S. Line

         Ft. from E. Line

330 Ft. from W. Line

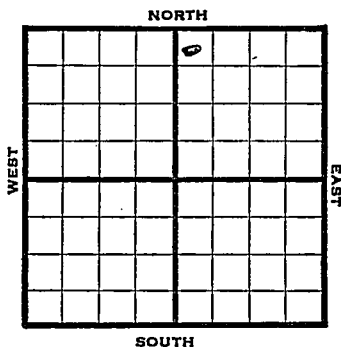

NW NE

Elev. 1940 REPORT

1946

11/20 Location

11/27 Spud

12/3 Anhy 405'  
Drllg 2783'

12/10 Lans 2927  
Arb 3273'  
TD 3278'  
5" @ 3275 RUST

12/17 TD 3281 swb 3 oil PH 12 hrs.

1947

1/4 TD 3281'  
Swb 3 oil PH 12 hrs

1/8 " " "

1/15 " " "

1/22 Arb 3273'  
5" @ 3275'  
TD 3281'  
Pump 120 Pot  
41.9 Grav.

COMPLETED

Map No. 46 Sec. 13 Twp. 19 R. 10W

Well No. 2 Emerick

Lebsack etal. Company

FIRST REPORT

Contractor

NW NE

SECTION PLAT

330 Ft. from N. Line

         Ft. from S. Line

         Ft. from E. Line

330 Ft. from W. Line

|  |  |   |  |
|--|--|---|--|
|  |  | 0 |  |
|  |  |   |  |
|  |  |   |  |
|  |  |   |  |
|  |  |   |  |

Rice County

Location X

Rig up         

Drilling and Remarks:

RECORD

Cased          in.          ft.

Sand         

Gas         

Oil         

Total Depth         

PRODUCTION

1st 24 hrs. Nat.         

1st 24 hrs. after shot         

Gas          Cu. Ft.

Dry Hole         

Abandoned         

Date

NOV 20 1946 19

S. J. LEWIS Scout

Map No. 416 Sec. 13 Twp. 19 R. 10W

Well No. 2 Emerick

Lebsack et al.

Company

COMPLETE

Contractor

NW NE

E. 1940  
SECTION PLAT

330 Ft. from N. Line

\_\_\_\_\_ Ft. from S. Line

\_\_\_\_\_ Ft. from E. Line

330 Ft. from W. Line

|  |  |   |  |
|--|--|---|--|
|  |  | 0 |  |
|  |  |   |  |
|  |  |   |  |
|  |  |   |  |

Rice County

Location \_\_\_\_\_

Rig up \_\_\_\_\_

Drilling and Remarks:





# RECORD

Cased \_\_\_\_\_ in., \_\_\_\_\_ ft.

Sand \_\_\_\_\_

Gas \_\_\_\_\_

Oil \_\_\_\_\_


# PRODUCTION

1st 24 hrs. Nat. \_\_\_\_\_

1st 24 hrs. after shot \_\_\_\_\_

Gas \_\_\_\_\_ Cu. Ft.

Dry Hole \_\_\_\_\_

Abandoned \_\_\_\_\_

Date

JAN 22 1947

19

S. J. LEWIS

Scout