

Rice


KANSAS

Section 13 Township 19 Range 10W

Well No. #4
#2 Katterjohn

Company C. H. Weaver

NORTH

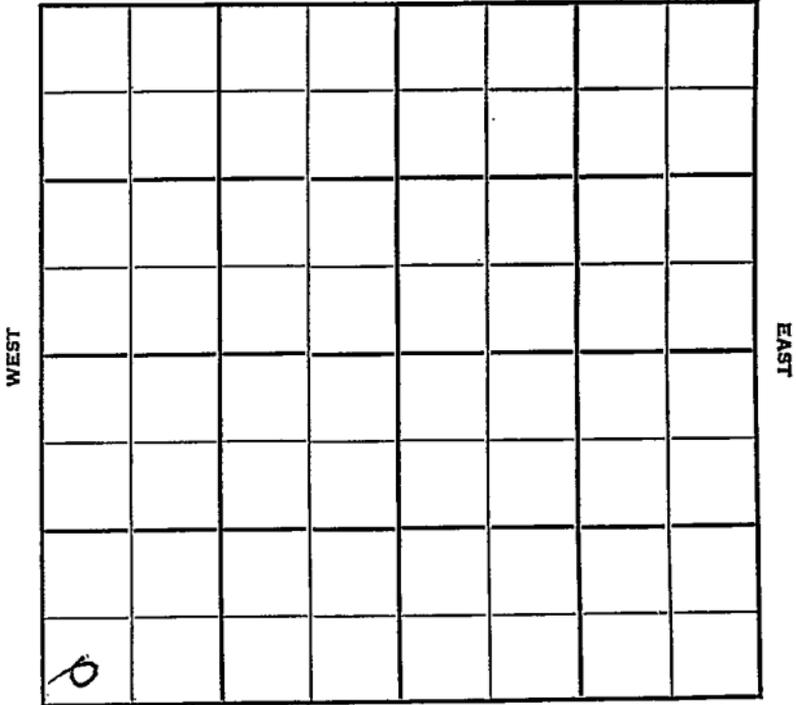

SOUTH

Rice

KANSAS

Sec. 13 Twp. 19 R. 10W

Well No. #4 ~~#2~~ Katterjohn Farm

C. H. Weaver Company

Gabbert & Jones - Contr. Contractor
Chase Pool


_____ Ft. from N. Line

430' Ft. from S. Line

_____ Ft. from E. Line

330' Ft. from W. Line

SW SW SW

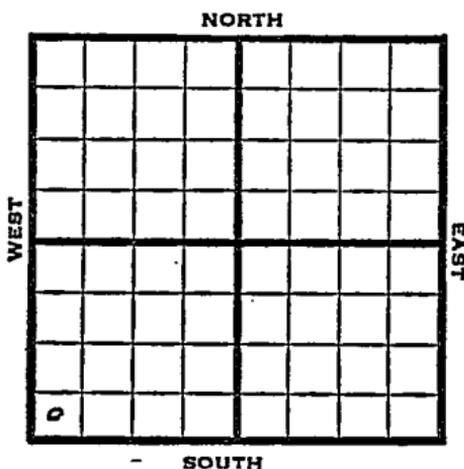

1950

Elev 1750' REPORT

11/22

Spud 11-17-50
8" @ 165'
Anhy 410-35
Drlg. 1318'

12/20

8" @ 165
Anhy 410-35 Br line 2130
Lans 2952 B KC 3226
Arb 3286-89
5" @ 3287
TD 3300
S/1 boph 500 A
Comp 35 bopd
Completed

COMPLETED

Kansas

Map No. _____ Sec. 13 Twp. 19 R. 10W

Well No. 4 Katterjohn

C. H. Weaver Company

CORRECTION Contractor

SW SW SW

SECTION PLAT

0			

_____ Ft. from N. Line

430 Ft. from S. Line

_____ Ft. from E. Line

330 Ft. from W. Line

Rice County

Location _____

Rig up _____

Drilling and Remarks:

Reported

$\frac{11}{11}2$

RECORD

Cased _____ in., _____ ft.

Sand _____

Gas _____

Oil _____

Total Depth _____

PRODUCTION

1st 24 hrs. Nat. _____

1st 24 hrs. after shot _____

Gas _____ Cu. Ft.

Dry Hole _____

Abandoned _____

Date

DEC 20 1950 19

J. E. TYRA Scout

