

Rice

Map No. **KANSAS** Sec. *13* Twp. *19* R. *10 W*


Well No. *Katterphon* Farm _____

James Davis Company _____

NORTH

WEST

EAST

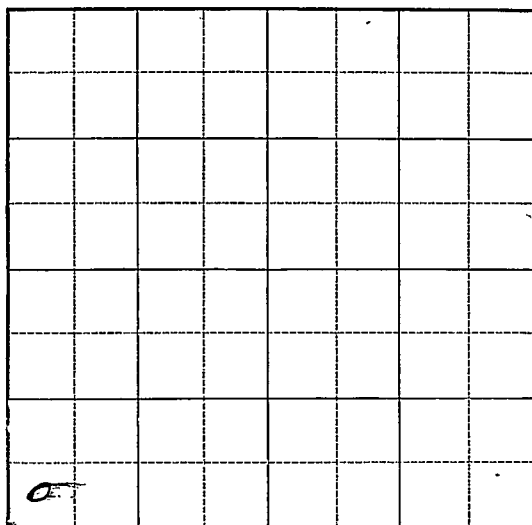

SOUTH

"SPECIAL"

Location _____

Drilling Remarks _____

Rig Up _____

Drilling Remarks _____

RECORD

Cased _____ in. _____ ft.

Sand _____

Gas _____

Oil _____

Total Depth _____

PRODUCTION

1st 24 hrs. Nat. _____

1st 24 hrs. after shot _____

Gas _____ cu. ft. _____

Dry Hole _____

Abandoned _____

Rice

Map No. KANSAS Sec. 13 Twp 19 R. 10W

Well No. 1 Katterpohn Farm

James Davis Company


 Ft. from N. Line

330 Ft. from S. Line

 Ft. from E. Line

330 Ft. from W. Line

"SPECIAL"

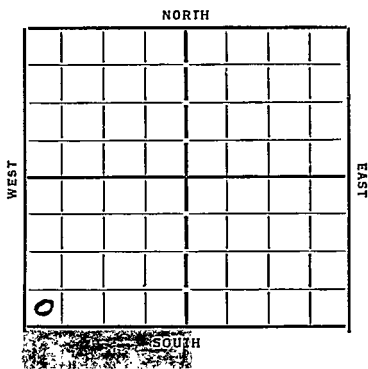

Date 1934

REPORT

EI. 1749

5/23 Location
5/31 Bldg. Rig
6/7 Rig
6/14 12" 427
6/21 10" 1212 SD Rep. boiler
6/28 UR 10" 1705
7/5 Dly 1905 (7/16 - Cong. 3260)
7/12 u.c. 8" 2460 s.o. 3295 Dlg. Rep
7/19 Dly 2900 8" 2452
7/27 Top Siliceous 3291
5" 3291 TD 3314
1000 feet oil in hole
Will swab well this afternoon
This is Siliceous line
formation & they may
acidize later (Tel)
7/28 Top Siliceous line 3291 TD 3314
Swabbed 25 Bbls & swabbed
down then let set 17 hrs.
& swabbed 18 Bbls. showing trace
of water 5" hanging 3298. Will
cement 5" 46.6 Grv. Will acidize
(Tel)

Map No. _____ Sec. _____ Twp. _____ R. _____

Well No. _____ Farm _____

_____ Company _____

NORTH

WEST

EAST

SOUTH

_____ Ft. from N. Line

_____ Ft. from S. Line

_____ Ft. from E. Line

_____ Ft. from W. Line

Date

REPORT

1934
8/2 TD 3314 Est 1 Bbl oil per hr
Cum 5" 3293
8/9 Shob 14 Bbls 22 hrs.
1000 acid on 7th
8/17 D. + A. T. D. 3338
2500 feet water hole
(Telegram)
8/22 Siliceous 3291 TD 3338 1/2
D & A

ABANDONED

Krey **KANSAS**
 Map No. *46* Sec. *13* Twp. *19* R. *10W*

Well No. *1-Katterjohn*

James Davis Company

James Davis Contractor

FIRST REPORTS

_____ Ft. from N. Line

330 Ft. from S. Line

_____ Ft. from E. Line

330 Ft. from W. Line

SPECIAL

SECTION PLAT

<i>0</i>			

Location *✓*

Rig up _____

Drilling and Remarks:

RECORD

Cased *34* in., _____ ft.

Sand *lean*

Gas _____

Oil _____

Total Depth _____

PRODUCTION

1st 24 hrs. Nat. _____

1st 24 hrs. after shot _____

Gas _____ Cu. Ft.

Dry Hole _____

Abandoned _____

Date

ORVAL MANNSCHRECK

5-23-34 19

Scout

Map No. 46 Sec. 13 Twp. 19 R. 10WWell No. 1-KatterjohnJames Davis Company

Contractor

ABANDONED

SPECIAL

SECTION PLAT

Ft. from N. Line

330 Ft. from S. Line

Ft. from E. Line

330 Ft. from W. Line

Location _____

Rig up _____

Drilling and Remarks:

105 A

RECORD

Cased _____ in., _____ ft.

Sand Sections 3291

Gas _____

Oil _____

Total Depth 3338 1/2

PRODUCTION

1st 24 hrs. Nat. _____

1st 24 hrs. after shot _____

Gas _____ Cu. Ft.

Dry Hole _____

Abandoned _____

Date

8-22-37 19 O. M. Manschreck Scout