


McPherson

Form 51-5M-2-29-34703

Map No. **KANSAS** Sec. 13 Twp. 19 R. 2W

Well No. 2-1-101 Farm Carey & Texas Company

NORTH

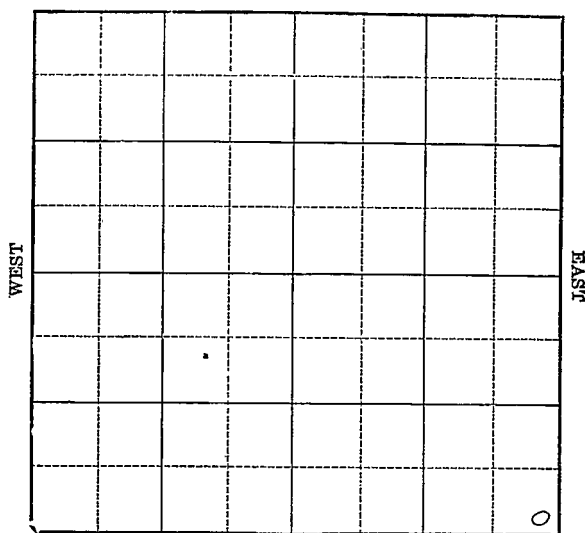

SOUTH

Location _____

Drilling Remarks _____

Rig Up _____

Drilling Remarks _____

RECORD

Cased _____ in. _____ ft.

Sand _____

Gas _____

Oil _____

Total Depth _____

PRODUCTION

1st 24 hrs. Nat. _____

1st 24 hrs. after shot _____

Gas _____ cu. ft.

Dry Hole _____

Abandoned _____

Map No. McPherson 13 Sec. 19 Twp. 2nd R. 2nd

Well No. 2- Holt Farm

Carey & Texas Co. Company

NORTH

WEST

EAST

SOUTH

 Ft. from N. Line

125 Ft. from S. Line

125 Ft. from E. Line

1931 Ft. from W. Line

Date

REPORT

2/30	Pond
1932	
1/6	Pos.
1/13	—
1/20	—
1/27	—
2/3	—
2/10	—
2/17	—
2/26	—
3/2	—
3/9	Spdg.
3/16	12"-1490
	Drilg 1520'
3/22	No report
3/30	—
4/6	8"-2941
	Top Chat 2941
	Drilg 2965
	show oil & gas
4/13	UIR 8"-3080'
	(over)

4/20- Base line 3137

Viola 3414-18

TD 3418

150' oil in hole

pull big pipe

Mill Cem 6"-3414

4/27- Top Viola 3415 (corrected)

1/2 bailed oil per hour
at 3425

TD 3426

shot 14 qt 3414-24

Oil out

5/4- Cased 6"-3415

Viola 3415-53 dry

Melcor 3460

HFV 3470-72

TD 3472

Abandon

43 KANSAS

Map No. _____ Sec. 13 Twp. 19 R. 2 W

Well No. 2 Haly

Cary & Texas Co. Company

Contractor

FIRST REPORTS

_____ Ft. from N. Line

125 Ft. from S. Line

125 Ft. from E. Line

_____ Ft. from W. Line

SECTION PLAT

			0

Location _____

Rig up _____

Drilling and Remarks:

Pond

RECORD

Cased _____ in., _____ ft.

Sand _____

Gas _____

Oil _____

Total Depth _____

PRODUCTION

1st 24 hrs. Nat. _____

1st 24 hrs. after shot _____

Gas _____ Cu. Ft.

Dry Hole _____

Abandoned _____

Date

DEC 30 1931

CHAS. L. SHERWOOD Scout

W. A. C.
W. A. C.

Returned	<i>JP</i>
Cards	
Tracing	<i>OK</i>
France Map	<i>X</i>
Scarborough Map	<i>X</i>
Moody Map	<i>X</i>
Scarborough Plat Book	
Moody Plat Book	

McPherson

43 KANSAS

Map No. _____ Sec. 13 Twp. 19 R. 2

Well No. 2 Holy

Carey & Texas Co. Company

Contractor

COMPLETED

_____ Ft. from N. Line


125 _____ Ft. from S. Line

125 _____ Ft. from E. Line

_____ Ft. from W. Line

ABANDONED

SECTION PLAT

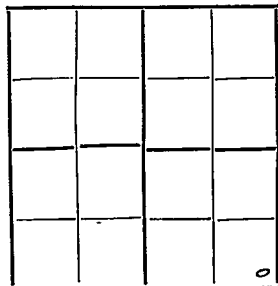

Location _____

Rig up _____

Drilling and Remarks:

Top W. 1/2 Cox 3460

HF W 3470-72

RECORD

Cased 6 in., 3415 ft.

Sand Viola 3415-53

Gas Dry

Oil _____

Total Depth 3472

PRODUCTION

1st 24 hrs. Nat. _____

1st 24 hrs. after shot _____

Gas _____ Cu. Ft.

Dry Hole ☒Abandoned ☒

Date

MAY 4 1932 CHAS. L. SHERWOOD

192

Scout

[Handwritten signature]

Returned	<i>[initials]</i>
Cards	<i>[initials]</i>
Tracing	<i>[initials]</i>
France Map	<i>[initials]</i>
Scarborough Map	<i>[initials]</i>
Moody Map	<i>[initials]</i>
Scarborough Plat Book	<i>[initials]</i>
Moody Plat Book	<i>[initials]</i>