

M^cPherson


Form 51-5M-2-29-34703

Map No. **KANSAS** Sec. 13 Twp. 19 R. 2^W

Well No. 3-Lovett Farm

Manolivid - M^cBride Company

NORTH Amorada

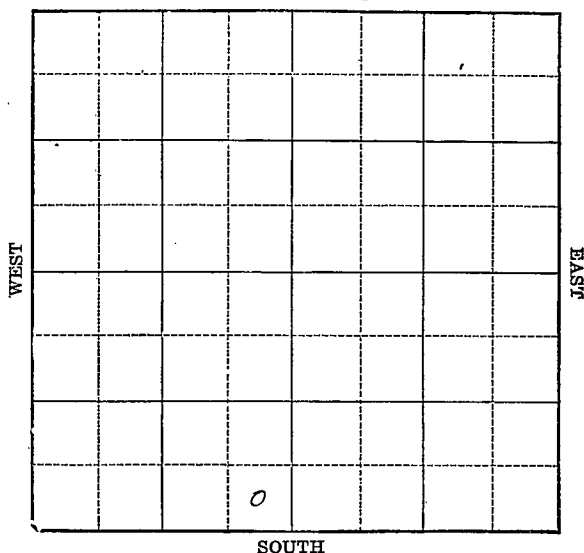

Location _____

Drilling Remarks _____

Rig Up _____

Drilling Remarks _____

RECORD

Cased _____ in. _____ ft.

Sand _____

Gas _____

Oil _____

Total Depth _____

PRODUCTION

1st 24 hrs. Nat. _____

1st 24 hrs. after shot _____

Gas _____ cu. ft.

Dry Hole _____

Abandoned _____

Map No. **KANSAS** Sec. 13 Twp. 19 R. 2^w

Well No. 3- Lovett Farm

Stanolind-M^cBride Company
& Amvada- NORTH


 Ft. from N. Line

330 Ft. from S. Line

330 Ft. from E. Line

 Ft. from W. Line

1932

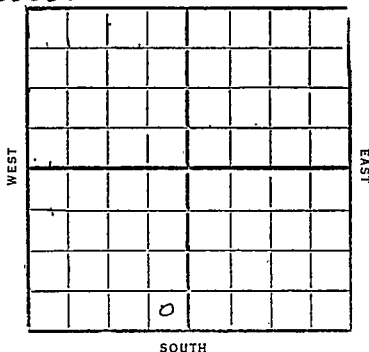

Date REPORT

5/11	Rotary rig
5/18	Rull
5/25	
6/1	Cem 16"- 96
	Drlg 1062
6/8	" 2153'
6/15	Chat 2929 2919
	Drlg 3097 show gas
6/22	Top Chat 2919' (SLM)
	Base line 3126
	Viola 3394-95"
	Cem 8"- Rust
6/29	Viola 3394-3407
	swab 47 bbl 17 hrs
	will shoot
7/6	TD 3407
	swab 47 bbl per hr
	for 17 hrs
	Rng tubing
	(over)

7/13-

Cased 8"-3394
Viola 3394-3406
TD 3406
shat 20 qt 3396-3406
Potential prod
1736 bbl oil
Comp.

43 KANSAS

Map No. _____ Sec. 13 Twp. 19 R. 2^W

Well No. 3 Louett

Stano line Mc Bride & Amerada Company

Contractor

FIRST REPORTS

SECTION PLAT

_____ Ft. from N. Line

330 Ft. from S. Line

330 Ft. from E. Line

_____ Ft. from W. Line

Location _____

Rig up Rotary Rig

Drilling and Remarks:

RECORD

Cased _____ in., _____ ft.

Sand _____

Gas _____

Oil _____

Total Depth _____

PRODUCTION

1st 24 hrs. Nat. _____

1st 24 hrs. after shot _____

Gas _____ Cu. Ft.

Dry Hole _____

Abandoned _____

Date

MAY 1 1 1932

CHAS. L. SHERWOOD

192

Scout

[Handwritten signature]

Returned	<i>[initials]</i>
Cards	<i>[initials]</i>
Tracing	<i>[initials]</i>
France Map	<i>[initials]</i>
Scarborough Map	<i>[initials]</i>
Moody Map	<i>[initials]</i>
Scarborough Plat Book	<i>[initials]</i>
Moody Plat Book	<i>[initials]</i>

43

KANSAS

McPherson

W

Map No. _____ Sec. 13 Twp. 19 R. 2

Well No. 3 Lovett

Stanline-McBride-Amesada Company

Contractor

COMPLETED

SECTION PLAT

Ft. from N. Line

330 Ft. from S. Line

330 Ft. from E. Line

Ft. from W. Line

Location _____

Rig up _____

Drilling and Remarks:

Shot 20/3396-3406

Potential Prod

1736 Bbls.

RECORD

Cased, 8 in., 3394 ft.

Sand Viola 3394-3406

Gas _____

Oil _____

Total Depth 3406

PRODUCTION

1st 24 hrs. Nat. _____

1st 24 hrs. after shot _____

Gas _____ Cu. Ft.

Dry Hole _____

Abandoned _____

Date

JUL 13 1932

192

CHAS. L. SHERWOOD

Scout

Returned 75
Cards 1
Tracing 2
France Map 1
Scarborough Map 1
Moody Map 1
Scarborough Plat Book 1
Moody Plat Book 1