

KANSAS


FORM 51 5M 6-46 PETROL

McPherson county

Section 13 Township 19 Range 2-W

Well No. #1, Johnson

Company Bay Petroleum and Westgate-Greenland

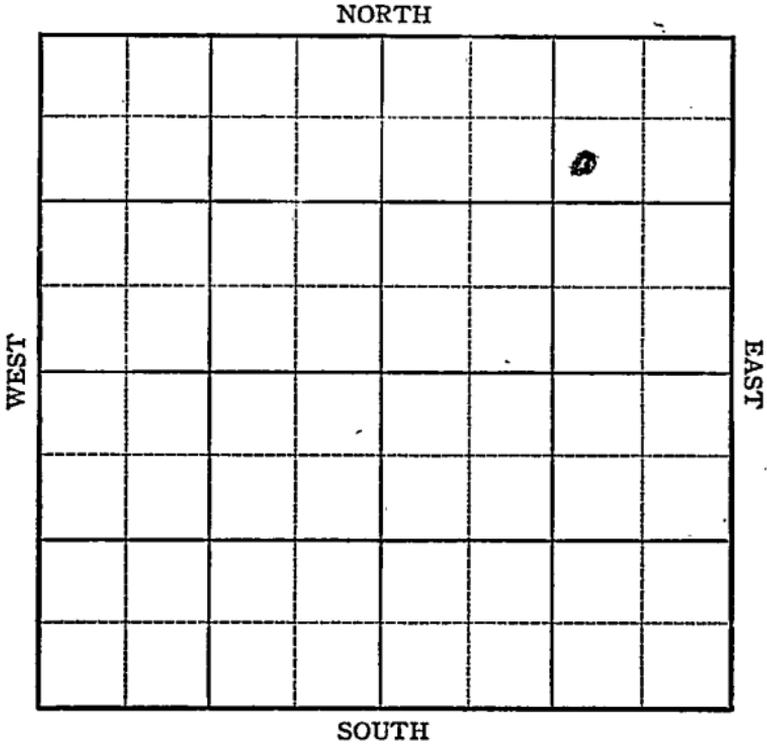

KANSAS

McPherson county

Sec. 13 Twp. 19 R. 2-W

Well No. #1, Johnson Farm

Bay Pet. and Westgate-Greenland Company

Ritz-Canton


990' Ft. from N. Line

_____ Ft. from S. Line

990' Ft. from E. Line

_____ Ft. from W. Line

SW NE NE

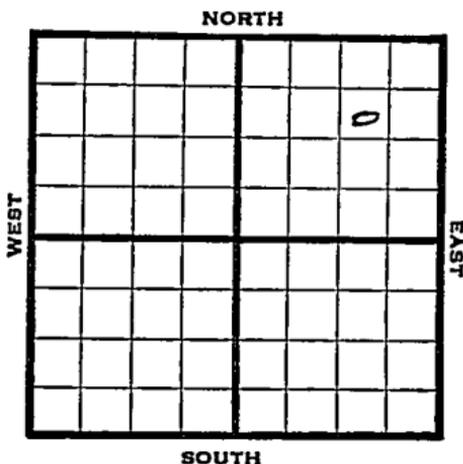

1946

Elev. 1564'

REPORT

10/30 Shell well plugged.

11/6 8" @ 178
Drlg 960'

11/12 Lans 2340
Miss 2938'
Drlg 3170'

11/20 Viola 3434'
TD 3454'

ABANDONED

Map No. 48 Sec. 13 Twp. 19 R. 2WWell No. 1 JohnsonBay Pet. & Westgate-Greenland Company

FIRST REPORT

Contractor

SW NE NE

SECTION PLAT

990 Ft. from N. Line Ft. from S. Line990 Ft. from E. Line Ft. from W. Line

			a

McPherson County

Location XRig up

Drilling and Remarks:

Shell well
plugged

RECORD

Cased in., ft.Sand Gas Oil Total Depth

PRODUCTION

1st 24 hrs. Nat. 1st 24 hrs. after shot Gas Cu. Ft.Dry Hole Abandoned

Date

OCT 30 1946 19S. J. LEWIS Scout

