


McPherson

Form 51—5M—11-31—Palace

Map No. KANSAS Sec. 13 Twp. 19 R. 20

Well No. 5 Lovett Farm
Stanolind et al Company

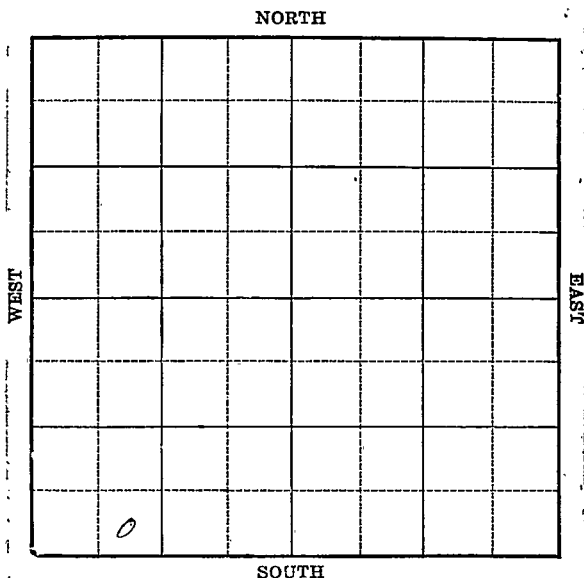

Location _____

Drilling Remarks _____

RECORD

Cased _____ in. _____ ft.

Sand _____

Gas _____

Oil _____

Total Depth _____

Rig Up _____

Drilling Remarks _____

PRODUCTION

1st 24 hrs. Nat. _____

1st 24 hrs. after shot _____

Gas _____ cu. ft.


Dry Hole _____

Abandoned _____

Map No. 7 Sec. 13 Twp. 19 R. 24

Well No. 5 Lovett Farm
Stanolind et al Company

990' Ft. from W. Line

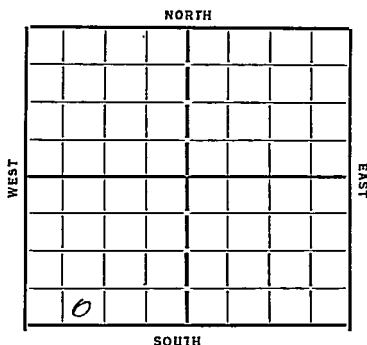

Date 7/33

REPORT

12/27 Loc

4/11 moving in

117 Rigging Rotaries

1/24 Orig 870

1/31	"	2050
------	---	------

217 Gap Chet 2916 Dely 2960

2/14 Run 7" 3289

2/23 Rust

2/1	Viola 3398 75 3410 Run
	tubing 500' oil

2/8	1000 Gal acid Pump 480
	Bkls 24 hrs.

3/14 Visla 3389 95 3410
1000 Hal acid 496 Pot

COMPLETED

Map No. 43 Sec. 13 Twp. 19 R. 2W

Well No. 5- Lovett

Stanolind et al Company

Contractor

FIRST REPORTS

SECTION PLAT

Ft. from N. Line

330 Ft. from S. Line

Ft. from E. Line

990 Ft. from W. Line

0			

Location ✓

Rig up

Drilling and Remarks:

RECORD

Cased in., ft.

Sand

Gas

Oil

Total Depth

PRODUCTION

1st 24 hrs. Nat.

1st 24 hrs. after shot

Gas Cu. Ft.

Dry Hole

Abandoned

Date

12-27-33 192 O. Mannschuck Scout

Map No. 43 Sec. 13 Twp. 19 R. 2WWell No. 5-LovettStanolind et al Company

Contractor

COMPLETED

SECTION PLAT

0			

Ft. from N. Line

330 Ft. from S. Line

Ft. from E. Line

990 Ft. from W. Line

Location

Rig up

Drilling and Remarks:

1000 and496
pot.

RECORD

Cased _____ in., _____ ft.

Sand Viola 3389

Gas _____

Oil _____

Total Depth 3410

PRODUCTION

1st 24 hrs. Nat. _____

1st 24 hrs. after shot _____

Gas _____ Cu. Ft.

Dry Hole _____

Abandoned _____

Date

3-14-34 192 O. Marmur Scout