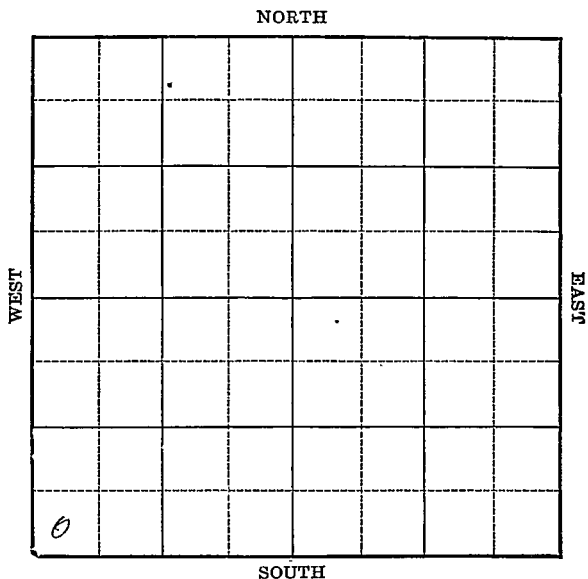


M. C. Pherson

Map No. KANSAS Sec. 13 Twp. 19 R. 2^WWell No. 4 Lovett Farm
Stanolind, Amerada & McBride CompanyLocation _____
Drilling Remarks _____Rig Up _____
Drilling Remarks _____

RECORD

Cased _____ in. _____ ft.

Sand _____

Gas _____

Oil _____

Total Depth _____

PRODUCTION

1st 24 hrs. Nat. _____

1st 24 hrs. after shot _____

Gas _____ cu. ft.

Dry Hole _____

Abandoned _____

McPherson


KANSAS

Form 252-A
5M 4-32 MPCMap No. _____ Sec. 13 Twp. 19 R. 2WWell No. 4 - Lovett Farm _____Marion-Lander & McBride Company

_____ Ft. from N. Line

330 Ft. from S. Line

_____ Ft. from E. Line

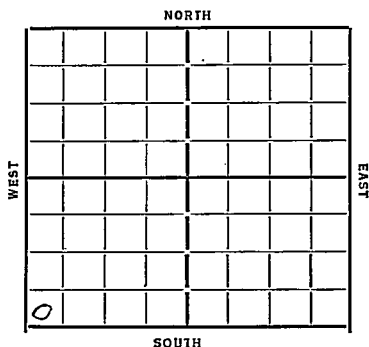330 Ft. from W. LineDate
1933

REPORT

7/12 Cellar7/19 _____7/26 Material8/2 Rotary rig8/9 drlg 1255'8/17 13" - 19' drlg 26008/23 Top Chat 3917 Viola 3376 - 6" 3375
T.D. 3378' RLLST8/30 _____9/6 TD 3403 swab 40 bbls 12 hrs. -
will acidize9/13 Viola 3378T. D. 3403512 bbls 24 hrs

COMPLETED

Map No. 43 Sec. 13 Twp. 19 R. 2 W

Well No. 4 - Lovett

Stanford, Amerada & McBride Company

Contractor

SECTION PLAT

Ft. from N. Line

330 Ft. from S. Line

Ft. from E. Line

330 Ft. from W. Line

FIRST REPORTS

Location

Rig up

Drilling and Remarks:

cellar

RECORD

Cased in., ft.

Sand

Gas

Oil

Total Depth

PRODUCTION

1st 24 hrs. Nat.

1st 24 hrs. after shot

Gas Cu. Ft.

Dry Hole

Abandoned

Date

7/17/33 192 Orval Mannschreck Scout

Map No. 43 Sec. 13 Twp. 19 R. 2W

Well No. 4 - Lovett

Stanolind - Emerald Company

Contractor

SECTION PLAT

Ft. from N. Line

330 Ft. from S. Line

Ft. from E. Line

330 Ft. from W. Line

COMPLETED

Location

Rig up

Drilling and Remarks:

512 bbls

RECORD

Cased in, ft.

Sand Viola 3378

Gas

Oil

Total Depth 3403

PRODUCTION

1st 24 hrs. Nat.

1st 24 hrs. after shot

Gas Cu. Ft.

Dry Hole

Abandoned

Date

9/13/33 192 O. Mannschreck Scout