


M^cPherson

Form 51-5M-2-29-34703

Map No. **KANSAS** Sec. *13* Twp. *19* R. *2^w*

Well No. *910* *M^c Bride et al* Farm Company

NORTH

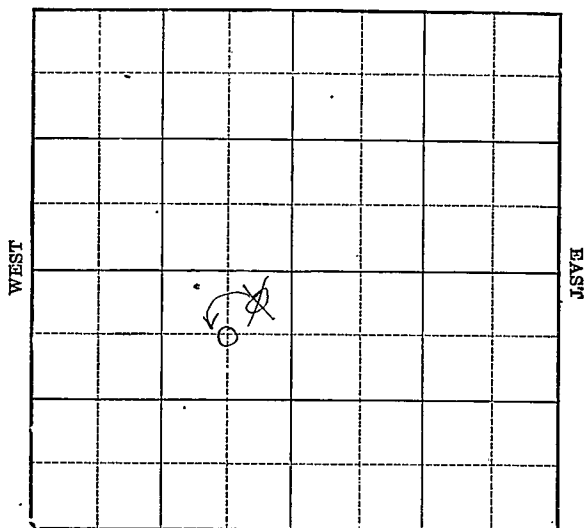

SOUTH

Location

Drilling Remarks

Rig Up

Drilling Remarks

RECORD

Cased in. ft.

Sand

Gas

Oil

Total Depth

PRODUCTION

1st 24 hrs. Nat.

1st 24 hrs. after shot

Gas cu. ft.

Dry Hole

Abandoned

Map No. KANSAS Sec. 13 Twp. 19 R. 2^w


Well No. 2- Lovett Farm
W.C. M^o Bride et al Company

660
330 Ft. from N. Line

660 Ft. from S. Line

330 Ft. from E. Line

1931 Ft. from W. Line

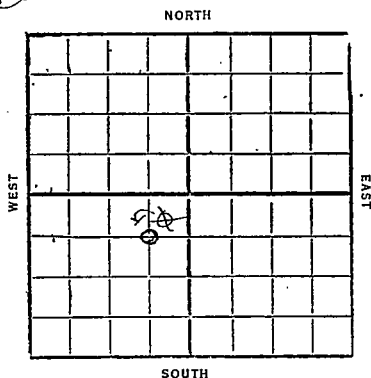

Date	REPORT
12/16	Loc
12/22	Chlat
12/30	Bldg rig
1932	
1/6	Run up
1/13	Spd g 105'
1/20	15" 402
1	Drly g 1100'
1/27	Let's 10"-1644'
2/3	Kreg 2117'
2/10	DIR 10"-2455'
2/17	10"-2452
	Dreg 2635'
2/26	8"-2913
	drly ahead
3/2	8" cp chat 2912
	Gauge 10,107,000 cu ft of gas at 2957
	2 bbl oil per hr at 2970
	T.D. 3002' Fishing
3/9	T.D. 3002' Oly out (over)

3/16- HF Wat 3007

Drly 3075'

3/22- Vire 8" 3110'

3/30- Cem 8" 3106'

Base line 3138'

Drly 3380'

4/6- Top Viola 3399-3407 1/2
swab 270 bbl 10 hrs

4/13- T.D. 3411 1/2'

shot 20 qt 3401-11 1/2'

swab 1061 bbl 24 hrs

4/20 —

4/27 —

5/4- S.D. 3411 1/2'

5/11 —

5/18 —

5/25 —

6/1- T.D. 3411 1/2'

Pump 120 bbl per day

6/8- T.D. 3411 1/2'

No potential

6/15- T.D. 3411 1/2'

Taking potential
Pump 52 bbls per hr
for 4 hrs

6/22- Viola 3399-3411 1/2'

T.D. 3411 1/2'

shot 20 qt 3401-11 1/2'

Potential prod

On pump 1366 bbl oil
Comp.

McPherson

#3 KANSAS

Map No. _____ Sec. 13 Twp. 19 R. 2 W

Well No. 2 Laverett

H. C. Mc Bride & Co. Company

Contractor

FIRST REPORTS

SECTION PLAT

330 Ft. from N. Line

_____ Ft. from S. Line

330 Ft. from E. Line

_____ Ft. from W. Line

	0		

Location ✓

Rig up

Drilling and Remarks:

RECORD

Cased _____ in., _____ ft.

Sand _____

Gas _____

Oil _____

Total Depth _____

PRODUCTION

1st 24 hrs. Nat. _____

1st 24 hrs. after shot _____

Gas _____ Cu. Ft.

Dry Hole _____

Abandoned _____

Date

DEC 16 1931

CHAS. L. SHERWOOD

192

Scout

Returned _____

Cards _____

Tracing _____

France Map _____

Scarborough Map _____

Moody Map _____

Scarborough Plat Book _____

Moody Plat Book _____

43 KANSAS

Map No. _____ Sec. 13 Twp. 19 R. 2 W

Well No. 2 Lester

H.C. Mc Bride et al Company

Contractor

CORRECTION


660 Ft. from N. Line

_____ Ft. from S. Line

660 Ft. from E. Line

_____ Ft. from W. Line

SECTION PLAT

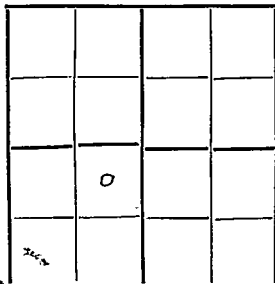

Location _____

Rig up Cellar

Drilling and Remarks: _____

Change location
to above.
from NE-NE-SW
to C-NE-SW

RECORD

Cased _____ in., _____ ft.

Sand _____

Gas _____

Oil _____

Total Depth _____

PRODUCTION

1st 24 hrs. Nat. _____

1st 24 hrs. after shot _____

Gas _____ Cu. Ft.

Dry Hole _____

Abandoned _____


Date

DEC 22 1931

192

CHAS. L. SHERWOOD

Scout

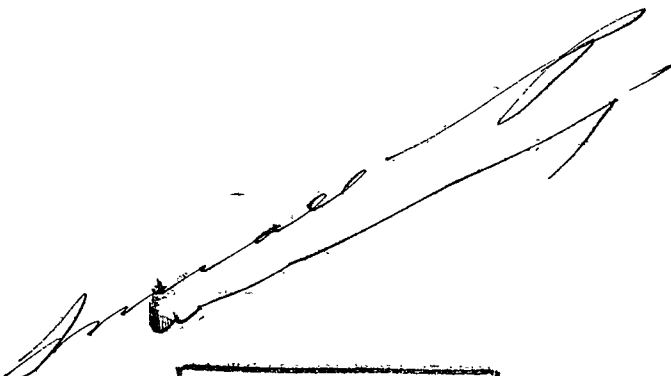

Returned.....

Cards.....

Tracing.....

France Map.....

Scarborough Map.....

Moody Map.....

Scarborough Flat Book.....

Moody Flat Book.....

43 **KANSAS** *McPherson*
 Map No. _____ Sec. *13* Twp. *19* R. *2* ^W

Well No. *2 Lovett*
H. Q. Mc Bride Co as _____ Company

 Contractor

COMPLETED

SECTION PLAT

	0		

660 Ft. from N. Line

_____ Ft. from S. Line

660 Ft. from E. Line

_____ Ft. from W. Line

Location _____

Rig up _____

Drilling and Remarks:

Shot 20/3401-11 1/2

Potential Prod
13 66 Bls

on pump

RECORD

Cased _____ in _____ ft.

Sand *Viola 3399-3411 1/2*

Gas _____

Oil _____

Total Depth *3411 1/2*

PRODUCTION

1st 24 hrs. Nat. _____

1st 24 hrs. after shot _____

Gas _____ Cu. Ft.

Dry Hole _____

Abandoned _____

Date

JUN 22 1932

CHAS. L. SHERWOOD

192

Scout

[Handwritten signature]

Returned	<i>[Signature]</i>
Cards	<i>[Signature]</i>
Tracing	<i>[Signature]</i>
France Map	<i>[Signature]</i>
Scarborough Map	<i>[Signature]</i>
Moody Map	<i>[Signature]</i>
Scarborough Plat Book	
Moody Plat Book	