

McPherson

KANSAS

SECTION 13 TOWNSHIP 19 RANGE 2W


WELL NO. #1-W F.A. Lovett

COMPANY Shell OilCo.

NORTH

WEST

EAST

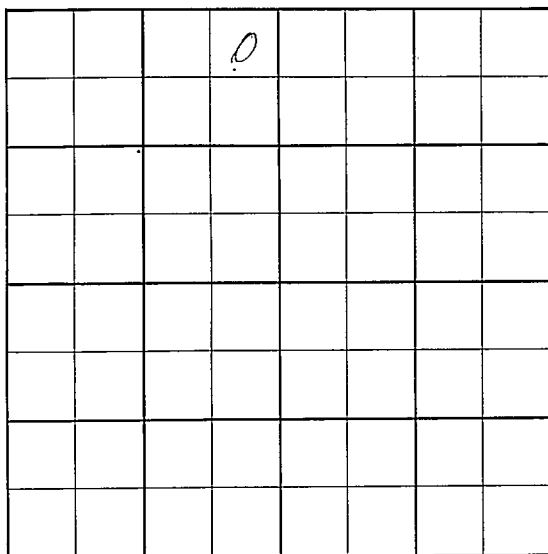

SOUTH

~~County~~ McPherson ~~Elev.~~
~~Sec.~~ 13 ~~Twp.~~ 19 ~~Rge.~~ 2W
~~Company~~ Shell Oil Co.
~~Farm Name~~ F. A. Lovett ~~No.~~ 1-W

TOPS	DEPTH	LOG	DATUM
Anh.			
Tr.			
H.			
Tr.			
Dg.			
Bl.			
L.			
K.C.			
B.K.C.			
Ce.			
C.			
M.			
M.			
K.			
Mz.			
Mo.			
V.			
S.			
S.			
A.			
R.			
PE.			
G.			
T.D.			

Loc. in Sec. NE NE NW


Geol. _____
Contr. _____
Sterling Drlg.

Pool _____
Ritz-Canton

FIRST REPORT

DEC 28 1956

Date Comm. 12-21-56
13" @ 277 w/300, Drlg. 1140, Combination
SWDW & Repressuring well

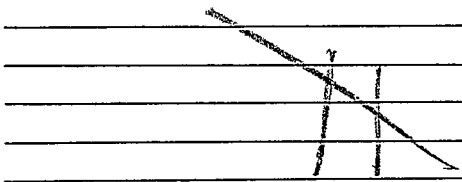

County McPherson Elev. 1562 DF
 Sec. 13 Twp. 19 Rge. 2W
 Company Shell Oil Co.
 Farm Name F. A. Lovett No. 1-W

TOPS	DEPTH	LOG	DATUM	Loc. in Sec.
Anb.				NE NE NW
Tr.				
H.				
Tr.				
Dg.				
BL.				
E.				Geol.
K.C.				Contr.
B.K.C.				
Ce.				
C.				Sterling Drlg.
M.		2909		
M.				Pool
K.		3120		Ritz-Canton
Mz.				
Mo.				
V.		3395		
S.				
S.				
A.				
R.				
PE.				
G.				
TD.	3427			

0
 FEB 13 '57
 ABANDONED

Date Comm. 12-21-56

13" @ 277 w/300, Drlg. 1140, Combination
SNDW & depressuring well JAN 2 '57 2588

JAN 9 '57 8.5/8 3396/250

JAN 19 '57 WOCT JAN 23 '57 CO 3427

10 5 1/2" W/PR to 3238 JAN 30 '57

FEB 6 '57 FEB 13 '57 input 639 BWPH
comp. for SUD well.

Rig to Rice