


McPherson **KANSAS**

SECTION 13 TOWNSHIP 19 RANGE 2W

WELL NO. #1-A Lovett

COMPANY Shell Oil

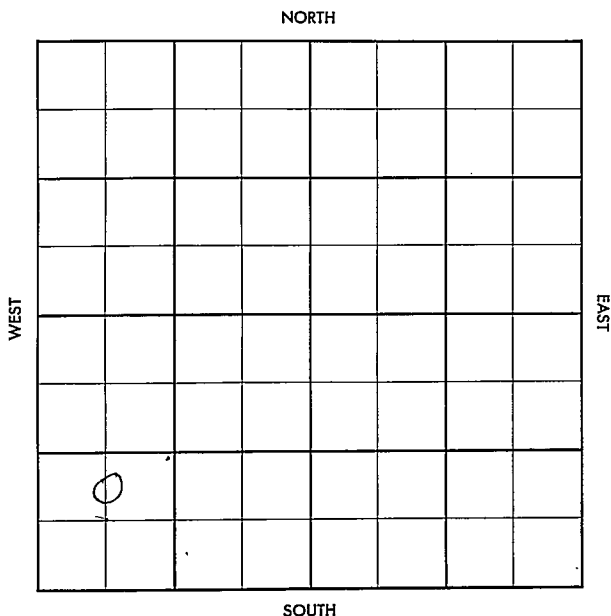

County McPherson Elev. 1559 GF
Sec. 13 Twp. 19 Rge. 2W
Company Shell Oil
Farm Name Lovett No. 1-A

TOPS	DEPTH	LOG	DATUM
Anh.			
TP.			
H.			
Tr.			
Dg.			
BL.			
L.			
K.C.			
B.K.C.			
Ce.			
C.			
M.			
M.			
K.			
Mz.			
Me.			
V.			
S.			
S.			
A.			
R.			
Pe.			
G.			
TD.			

Loc. in Sec. C N $\frac{1}{2}$ SW SW
800' SL
660' WL
Geol. _____
Contr. _____
K & E
Pool _____
Ritz-Canton

FIRST REPORT			
	SEP 19 '56		

Date Comm. 9-13-56
10" @ 218/200 drlg. 2100 SEP 26 '56

2271 S S 932

[Handwritten signature and scribbles]

CORRECTION

FORM 512 SUNRAY

County McPherson Elev. 1559 GP
 Sec. 13 Twp. 19 Rge. 2W 1561 DP
 Company Shell Oil
 Farm Name Lovett No. 1-A

TOPS	DEPTH	LOG	DATUM	Loc in Sec. <u>NW</u>
Anh.				C N 1/2 SW 3/4
Top				800' SL
H.				660' WL of NW
Tr.				
Dg.				
Bl.				
L.		2302		Geol.
K.C.				Contr.
B.K.C.				K & E
Ce.				Pool
C.		2895		Pitz-Canton
M.				
M.		3101		
K.				
Mz.				
Mo.				
V.		3371		
S.				
S.				
A.				
R.				
PE.				
G.				
TD.	3372			

COMPLETE

OCT 24 '56

Date Comm. 9-13-56
10" @ 218/200 d-1 g. 2100 SEP 25 '56
2" @ 3372/150 woc OCT 3 '56 CO
DD 3376 1300' Fluid in hole
P. 27 1/2 BO + 5472 BW in
59 hrs. w. 10 '56 ✓ OCT 17 '56 2 1/2 P.
28 BO + 3697 BW pd.
OCT 24 '56 P. 38 BO + 3697 BW
24 hrs.