


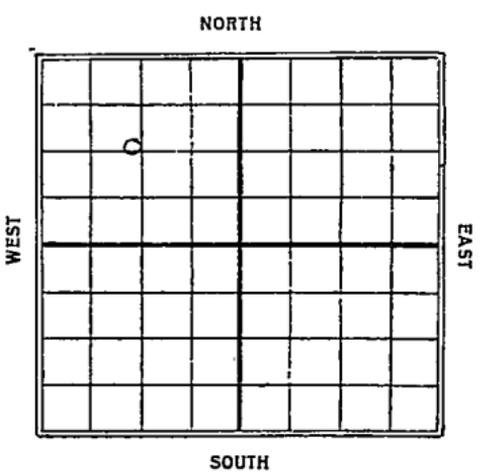

Map No. KANSAS Sec. 13 Twp. 19 R. 2w

Well No. 1- Lovett Farm  
M<sup>c</sup>Pherson Oil & Land Company

1313 Ft. from N. Line  
\_\_\_\_\_ Ft. from S. Line  
\_\_\_\_\_ Ft. from E. Line  
1312 Ft. from W. Line  
1913



Date	REPORT
8/6	Loc
8/13	
8/20	Fluid
8/27	Whl g. 760'
9/3	" 1510'
9/10	13"- 1647
	dry 1780'
9/17	" 2255'
9/24	" 2550'
10/1	W/R 8"- 2895'
10/18	Top Chat 2917
	Sum 8"
10/15	Chat 2914-46
	T.D. 2946
	18 1/2 M gas
	940# B.P.
	Corp.

*McPherson*

Map No. KANSAS Sec. 13 Twp. 19 R. 2 W

Well No. 43 *120018*

*McPherson Oil & Shell Company* Contractor

Contractor

**SECTION PLAT**


1313 Ft. from N. Line

\_\_\_\_\_ Ft. from S. Line

\_\_\_\_\_ Ft. from E. Line

1312 Ft. from W. Line

**FIRST REPORTS**

Location *✓*

Rig up \_\_\_\_\_

Drilling and Remarks:

**RECORD**

Cased \_\_\_\_\_ in., \_\_\_\_\_ ft.

Sand \_\_\_\_\_

Gas \_\_\_\_\_

Oil \_\_\_\_\_

Total Depth \_\_\_\_\_

**PRODUCTION**

1st 24 hrs. Nat. \_\_\_\_\_

1st 24 hrs. after shot \_\_\_\_\_

Gas \_\_\_\_\_ Cu. Ft.

Dry Hole \_\_\_\_\_

Abandoned \_\_\_\_\_

Date

AUG 6 1930  
19

S. J. LEWIS

Scout

*McPherson*  
 Map No. **KANSAS** Sec. *13* Twp. *19* R. *2W*  
*43*  
 Well No. *1 Lovell*

*McPherson Oil & Shell* Company

Contractor

## SECTION PLAT

*1313* Ft. from N. Line

..... Ft. from S. Line

..... Ft. from E. Line

*1312* Ft. from W. Line

COMPLETED


Location.....

Rig up.....

Drilling and Remarks:

*Chas 2914. - 46*

*940 # R. PL*

## RECORD

Cased.....in., .....ft.

Sand.....

Gas *18 1/2 M*

Oil.....

Total Depth *2946*

## PRODUCTION

1st 24 hrs. Nat.....

1st 24 hrs. after shot.....

Gas.....Cu. Ft.

Dry Hole.....

Abandoned.....

Date

*OCT 15 1930*

*S. J. LEWIS* Scout