


Map No. **KANSAS** Sec. **13** Twp. **19** R. **2^w**

Well No. **L- Lovett** Farm
~~H.O. McPherson~~ Company

Stanolind et. al
NORTH

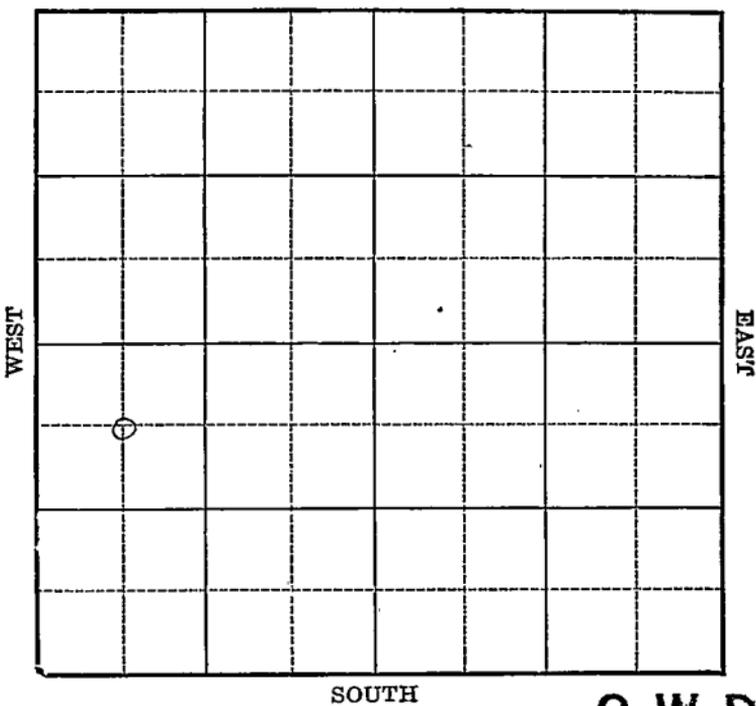

O. W. D. D

Location _____
Drilling Remarks _____

Rig Up _____
Drilling Remarks _____

RECORD

Cased _____ in. _____ ft.
Sand _____
Gas _____
Oil _____
Total Depth _____

PRODUCTION

1st 24 hrs. Nat. _____
1st 24 hrs. after shot _____
Gas _____ cu. ft.
Dry Hole _____
Abandoned _____

M^cPherson

Form 252A-5M-11-29-38055

Map No. KANSAS Sec. 13 Twp. 19 R. 2^w

Well No. 1- Lovett Farm
~~McPherson et al~~ Company

Standolind et al NO. 21


660 Ft. from N. Line

_____ Ft. from S. Line

_____ Ft. from E. Line

660 Ft. from W. Line

1930

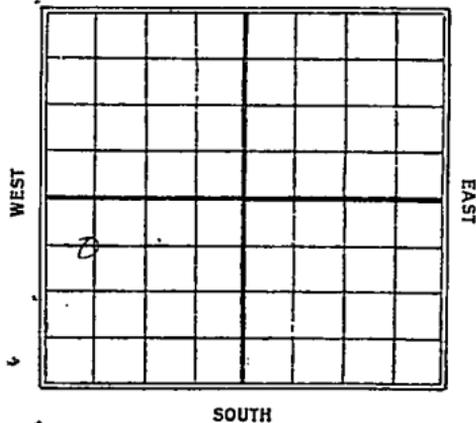

Date	REPORT	O. W. D. D
12/13	Bldy Rig	
12/10	Stand	
12/17	Drgy 840	
12/23	Run 12" - 1450	
12/30	WIR 13" at 1634	
1931		
1/17	Drgy 1900	
1/14	HFW 2160	
	Run 10" - 2352	
1/21	8" - 2601	
	Drgy 2607	
1/28	Chat 2900	
	show gas 2900-03	
	WIR 8" csg	
2/4	sem 8" - 2905'	
2/11	Top Chat 2907	
	Drgy 2920'	
	3 1/2 M gas	
2/18	T.D. 2952	
	12 3/4 M gas	
	and some oil	
2/25	T.D. 2952 (true big pipe)	

3/4- Chat 2907-52

T.D. 2952

1 2 3/4 # gas
and spray oil

900# R.P.

Comp.

1937

O. W. D. D

5/26

OTD 2952'.

T.D. 2961'.

1000 acid.

Potential 261 oil 4% water.

FIRST REPORT

and

COMPLETED

M. McPherson

Map No. **KANSAS** Sec. 13 Twp. 19 R. 2W

Well No. 43 1 Lovett

H. C. Mc Bride & Co Company

Contractor

SECTION PLAT

6			

660 Ft. from N. Line

..... Ft. from S. Line

..... Ft. from E. Line

660 Ft. from W. Line

FIRST REPORTS

Location.....

Rig up.....

Drilling and Remarks:

Building rig
JJ

RECORD

Cased..... in., ft.

Sand.....

Gas.....

Oil.....

Total Depth.....

PRODUCTION

1st 24 hrs. Nat.....

1st 24 hrs. after shot.....

Gas..... Cu. Ft.

Dry Hole.....

Abandoned.....

Date

DEC 3 1930

S. J. LEWIS

Scout

Handwritten scribbles and lines, possibly representing a signature or a set of initials.

Returned	<i>[Signature]</i>
Cards	
Tracing	<i>[Signature]</i>
France Map	<i>[Signature]</i>
Scarborough Map	<i>[Signature]</i>
Moody Map	<i>[Signature]</i>
Scarborough Plat Book	
Moody Plat Book	

W. Pearson

Map No. **KANSAS** Sec. 13 Twp. 19 R. 24

Well No. 1 Lovett

W. C. McBride & Co Company

Contractor

SECTION PLAT

660 Ft. from N. Line
 Ft. from S. Line
 Ft. from E. Line
660 Ft. from W. Line

COMPLETED

Location.....

Rig up..... *Open*

Drilling and Remarks:

spraying oil
900 # R. P.

RECORD

Cased..... in., ft.
 Band 2902 - 2952
 Gas 12 3/4
 Oil
 Total Depth 2952

PRODUCTION

1st 24 hrs. Nat.....
 1st 24 hrs. after shot.....
 Gas..... Cu. Ft.
 Dry Hole.....
 Abandoned.....

Date

MAR 4 1931

S. J. LEWIS Scout

Handwritten scribbles and lines, possibly representing a signature or a set of initials.

Returned	<i>AB</i>
Cards	<i>AB</i>
Tracing	<i>M/S</i>
France Map	✓
Scarborough Map	<i>[scribble]</i>
Moody Map	✓
Scarborough Plat Book	
Moody Plat Book	

KANSAS *McPherson*

Map No. 43 Sec. 13 Twp. 19 R. 2 W

Well No. 1 - Lovett

Stanolind et al (McBride) Company

~~FIRST REPORT~~ **CORRECTION** Contractor
Company Name
SECTION PLAT

COMPLETED

660 Ft. from N. Line

_____ Ft. from S. Line

_____ Ft. from E. Line

660 Ft. from W. Line

0			

OWDD

Location _____

Rig up _____

Drilling and Remarks:

OTD 2952

1000 Acid

Pot - 261

4 070 W 2 T

RECORD

Cased _____ in., _____ ft.

Sand _____

Gas _____

Oil _____

Total Depth 2961

PRODUCTION

1st 24 hrs. Nat. _____

1st 24 hrs. after shot _____

Gas _____ Cu. Ft.

Dry Hole _____

Abandoned _____

Date _____

Handwritten scribbles and initials, possibly including 'PSY'.

Returned	<i>Paul</i>
Cards	<i>JW</i>
Tracing	<i>MS</i>
France Map	<i>MS</i>
Scarborough Map	<i>MS</i>
Moody Map	<i>MS</i>
Scarborough Plat Book	<i>MS</i>
Moody Plat Book	<i>MS</i>