


Section 13 Township 19 Range 17 W

Well No. #1 A.E. Brazda

Company Fleming & Woodman & Mid-Plains

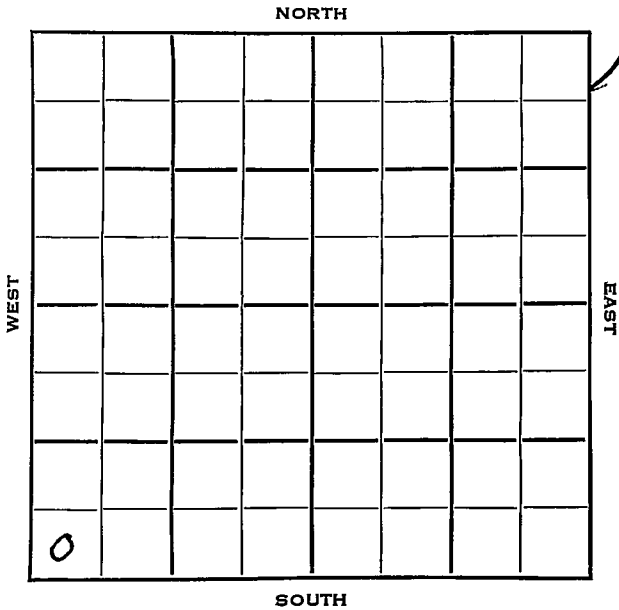

Rush

KANSAS



Sec. 13 Twp. 19 R. 17 W

Well No. # 1 A. E. Brazda Farm

Fleming & Woodman & Mid-Plains Company

Fleming & Woodman Contractor

Wildcat

\_\_\_\_\_ Ft. from N. Line


330 Ft. from S. Line

\_\_\_\_\_ Ft. from E. Line

330 Ft. from W. Line

SW SW SW

Skelly - DHM

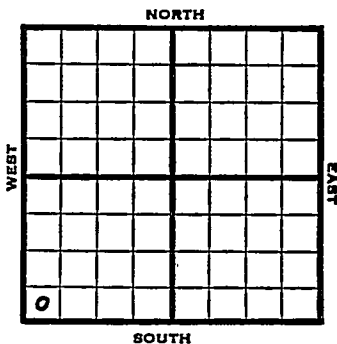

1953 Elev. 2124' REPORT

5/6 Spud 5-1-53  
8" @ 254 Anhy 1208'  
Drlg. 1508'

5/20 Spud 5-1-53  
D&A  
TD 3924  
8" @ 254  
Anhy 1208, Heeb 3471, Lans 3527, Cong  
3837, EroArb. 3851, Arb. 3882  
DST 3852-66, opn 20 mins., rec. 33'  
mud, 970#  
DST 3884-3924, opn 1/2 hrs., rec. 20'  
mud, 1210#  
TD 3924  
D&A

**ABANDONED**



