


Section 13 Township 19 Range 33-WWell Number #1 NolanCompany Blackman et al

2

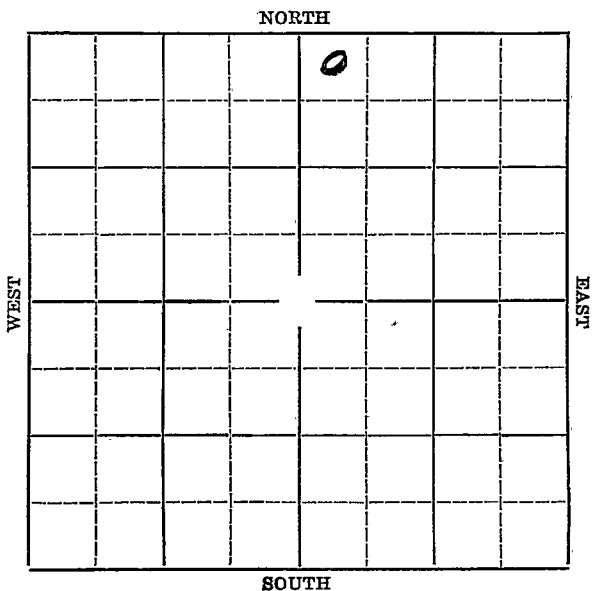

KANSAS, Scott

Form 252-A-5M-7-36-Palace

Sec. 13 Twp. 19 R. 33W

Well No. #1 Nolan Farm


Blackman et al Company

330' Ft. from N. Line

_____ Ft. from S. Line

_____ Ft. from E. Line

330' Ft. from W. Line

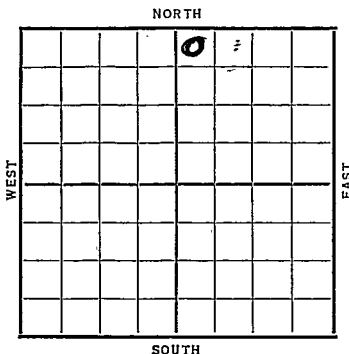

1936

REPORT

10/28 Location

11/6---11/12---11/19--

11/27---12/3--12/10--12/17--

12/24---12/29--

1937

1/7 Location

1/14 "

1/21 "

1/28 "

2/4 "

2/11 "

2/18 "

2/26 "

3/3 Location abandoned.

ABANDONED

KANSAS

Map No. W 19 N 7 E Sec. 18 Twp. 19 R. 33 WWell No. 1 NolanBlackman & Co Company

Contractor

SECTION PLAT

		0	

330 Ft. from N. Line

X: v

Ft. from S. Line

Ft. from E. Line

830 Ft. from W. Line

FIRST REPORT

Location ✓

Rig up

Drilling and Remarks:

RECORD

Cased _____ in., _____ ft.

Sand _____

Gas _____

Oil _____

Total Depth _____

PRODUCTION

1st 24 hrs. Nat. _____

1st 24 hrs. after shot _____

Gas _____ Cu. Ft.

Dry Hole _____

Abandoned _____

Date

28 1936

19

S. J. LEWIS Scout

KANSAS

Map No. No Map Sec. 13 Twp. 19 R. 33WWell No. 1 NolanBlackman & Co Company

Contractor

SECTION PLAT

		6	

320 Ft. from N. Line

_____ Ft. from S. Line

_____ Ft. from E. Line

320 Ft. from W. Line

ABANDONED

Location ✓

Rig up _____

Drilling and Remarks:

RECORD

Cased _____ in., _____ ft.

Sand _____

Gas _____

Oil _____

Total Depth _____

PRODUCTION

1st 24 hrs. Nat. _____

1st 24 hrs. after shot _____

Gas _____ Cu. Ft.

Dry Hole _____

Abandoned ✓

Date

MAR 3 1937₁₉

S. J. LEWIS Scout