


SECTION 13 TOWNSHIP 19 RANGE 16W

WELL NO. #1 Grunwald

COMPANY Shelly-Miller & Metro. Paving, etal

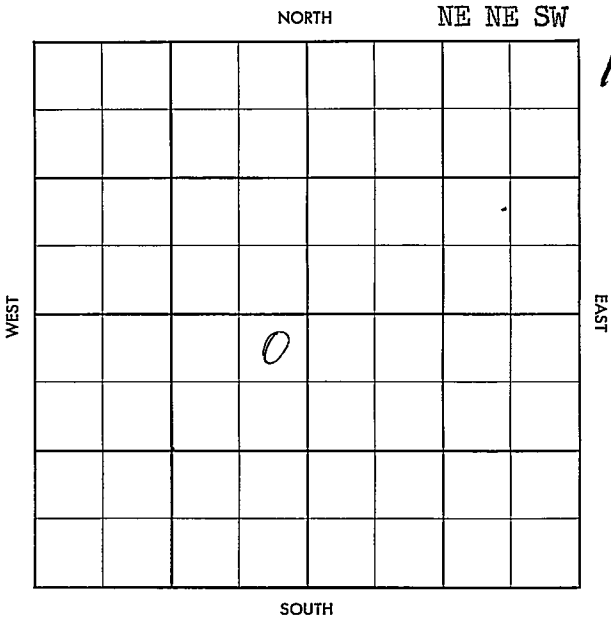

WILDCAT

FORM 513 SUNRAY

County Huish Elev. _____
Sec. 13 Twp. 19 Rgs. 16W
Company Sholly-Miller & Metro. Paving etal.
Farm Name Grunwald No. 1

TOPS	DEPTH	LOG	DATUM	Loc. in Sec.
Anh.				<u>NE NE SW</u>
Tp.				
H.				
Tr.				
Dg.				
Bl.				
L.				Geol. _____
K.C.				Contr. _____
B.K.C.				<u>Co. tools</u>
Ce.				
C.				
M.				
M.				Pool
K.				<u>Wildcat</u>
Mz.				
Me.				
V.				
S.				
S.				<u>FIRST REPORT</u>
A.				
R.				
PE.				
G.				
T.D.				<u>MAY 8 '57</u>

Date Comm. Skelly & Texas - DHM
Location _____

~~N~~ ~~K~~

County Rush Elev. 2010
 Sec. 13 Twp. 19 Rge. 16W
 Company Shelly-Miller & Metro. Paving etal.
 Farm Name Grunwald No. 1

TOPS	DEPTH	LOG	DATUM
Anh.	1035		
Tp.			
H.	3287		
Tr.			
Dg.			
Bl.	3359		
L.	3370		
K.C.			
B.K.C.			
Ce.			
C.	3652		
M.			
M.	3677		
Mz.			
Mq.			
V.			
S.			
S.			
A	3681		
R.			
PE			
G.			
T.D.	3705		

Loc. in Sec. NE NE SW

Geol. _____

Contr. _____

Co. tools

Pool

Wildcat

ABANDONED

MAY 22 '57

Date Comm. Skelly & Texas - DEM

Location MAY 15 '57 5-10-57 25/8

1040/500 @ 2335 MAY 22 '57

DST 3650-65 1hr G/55" rec

35' GCM BHP 993 DST

3677-90 1hr G/7" rec 90' GCM

BHP 1028/ DST 3690-3705

1hr 120' SOC 9554 Md + 60'

50' GCM + 300' SULF wth BHP

1082/ D & Q.