

LAUGHLIN-SIMMONS & CO. OF KANSAS, INC.

OILWELL ELEVATIONS AND LOCATION
2121 W. 18TH STREET (316) 5351
WICHITA, KANSAS 67203

KW1021786

October 21, 1978

DATE

NOV 14 1978

Barton

15 19s 14w

C SW SW

COUNTY

S T R

LOCATION

Rupe Oil Co. Inc.

1

Dunekack

OPERATOR


NO.

FARM

ELEVATION: 1886 DF
1881 Gr

Glen N. Rupe
Box 2273
Wichita, KS 67201

SCALE:

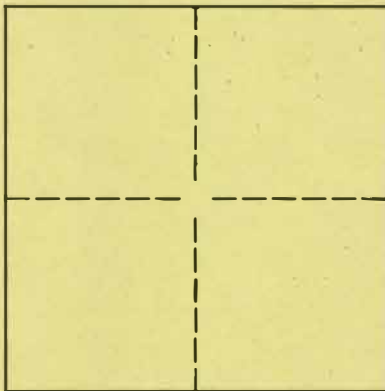

DUPLICATE

*mailed copy
for client
10/23/78*

MINIMUM STAKING CHARGE:
(INCLUDES GROUND ELEVATION)

\$10.00 WC

EXTRA TIME & MILEAGE:

\$50.00

ELEVATION CHARGE:

\$60.00

TOTAL:

Larry Riffey/js

L-S SURVEYOR