


Section 14 Township 19 Range 12-W

Well No. #14 Lanterman "B"

Company George Hannum

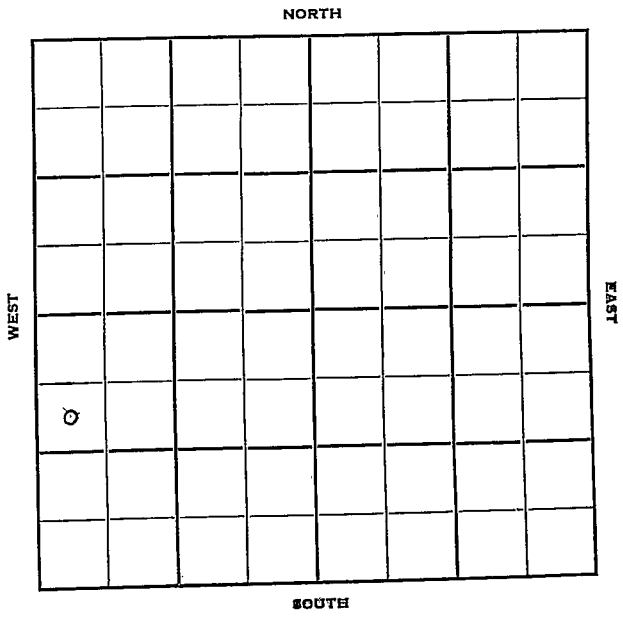

12

Sec. 14 Twp. 19 R. 12W

Well No. #4 Lanterman "B" Farm

George Hannum

Company

Contractor

Cheyenne View Pool

990'

Ft. from N. Line


Ft. from S. Line

Ft. from E. Line

330'

Ft. from W. Line

SW NW SW

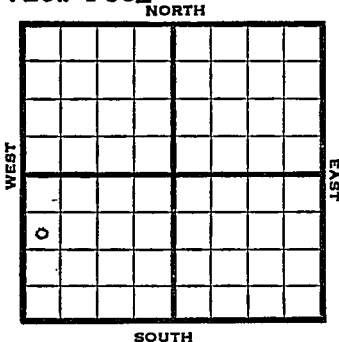

1950

REPORT

9/20

MIR

10/18

Spud 9-20-50
Oil Well TD 3462
8-5/8" @ 886' Br Lime 3139'
Lans. 3154'
DST 3158-3210 opn 15 min.
Rec. 2550' O&GCM Congl 3427'
Arb. 3433-41' 5" @ 3439'
TD 3455'
SSO 500 A $\frac{1}{2}$ BOPH DD 3460
1000 A DD 3462 1000 A
PB 3400 16/3204-08 8/3199-3201
22/3177-83 23/3171-77
12/3168-71 23/3148-54 1000 A
Comp. 3000 BOPD

COMPLETED

J. E. TYRA

County Barton State KansasSec. 14 (Blk. Twp.) 19 (Sur. Rge.) 12W Map No.Operator Geo. HannumWell No. 4 Farm Lanterman "B"Elev. 1863 Location SW NW SW

990 Ft. From N Line SW330 Ft. From W Line Quarter

1st. Report

Completion OCT 18 1950Remarks Cheyenne View PoolSpudding Date 9-20-50Drlg. Data Oil well TD 34628 5/8" @ 886 Br. line 3139 Lans. 3154DST 3158-3210 open 15 min. Rec. 2550'o & gcm Cong. 3427 Arb. 3433-415" @ 3439 TD 3455 SSO 500 A1/2 boph DD 3460 1000 A DD 34621000 A PB 3400 16/ 3204-088/ 3199-3201 22/ 3177-83 23/ 3171-7712/ 3168-71 23/ 3148-54 1000 AComp. 3000 bopd