

Sec. 14 Twp. 19 R. _____

Well No. #3 Lanterman "B" Farm _____

Geo. H Hannum Company _____

Contractor _____

Cheyenne View


_____ Ft. from N. Line

990 Ft. from S. Line

_____ Ft. from E. Line

330 Ft. from W. Line

NW SW SW

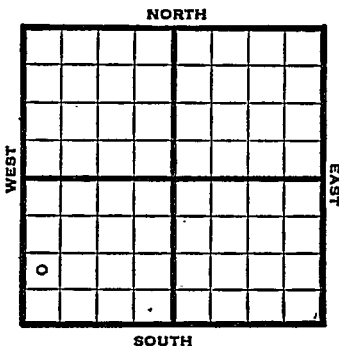

1950 Elev 1866 REPORT

9/6 Spud 9-4-50
8" @ 252
WOC

10/18 Spud 9-4-50
Oil Well TD 3463'
8" @ 252' Anhy 680-705
Top. 2790' Br Lime 3148'
Lans. 3164'
DST 3165-3214' opn 15 min
Rec. 200' O&GCM 100' oil & mud
Cong. 3419' Ch. Cong. 3434'
Arb. 3454-63 5" @ 3460'
15/3163-68 24/3180-88 9/3206-09
12/3212-16 1000 A
Comp. 175 BOPD

COMPLETED

