


Section 14 Township 19 Range 12-W

Well No. #1 Gill

Company Aledo & Murfin

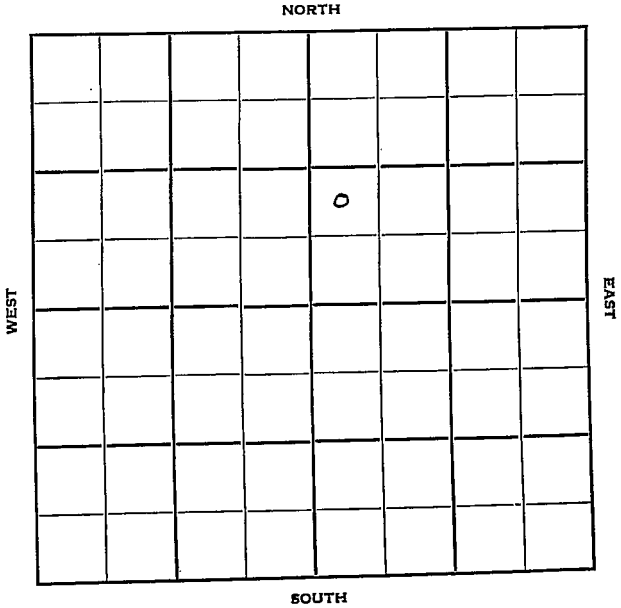

Sec. 14 Twp. 19 R. 12W ✓

Well No. #1 Gill Farm

Aledo & Murfin Company

Murfin Drlg. Contractor


_____ Ft. from N. Line

990' Ft. from S. Line

_____ Ft. from E. Line

330' Ft. from W. Line

NW SW NE

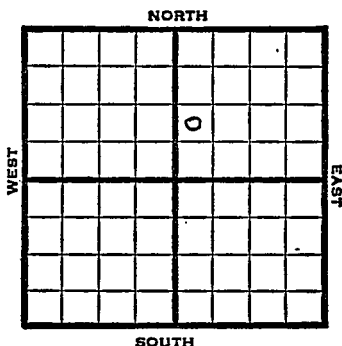

1950 Elev 1846 REPORT

6/28 Rig up
 8/9 8 5/8" @ 197
 Anhy 665 Heeb 3002
 Br lime 2119 Lans 3136
 DST 3139-3215 opn 50 min rec 120' o &
 gcm 600' oil
 DST 3271-3325 opn 1 hr rec 75' wtr
 & GCM
 Cong 3397
 TD 3451
 5" @ 3325 18/3208-14 SP 3200
 6/3190-92 SSO 15/3161-66 900' oil
 in 14 hr 3000A F/110 bopd
 Comp 333 bopd 6% wtr
 Completed

COMPLETED

County Barton State KansasSec. 14 (Blk.
Twp.) 19 (Sur.
Rge.) 12W Map No.Operator Aledo & MurfinWell No. 1 Farm GillElev. 1846 Location NW SW NE

990 Ft. From S Line NE

330 Ft. From W Line Quarter

1st. Report

Completion AUG 9 1950

Remarks

Spudding Date

Drlg. Data

8 5/8" @ 197 Anhy 665 Heeb. 3002Br. lime 3119 Lans. 3136 DST 3139-3215open 50 min. Rec. 120' o & gcm 600' oilDST 3271-3325 open 1 hr. Rec. 75' water& gas cut mud Cong. 3397 TD 34515" @ 3325 18/ 3208-14 SP 32006/ 3190-92 SSO 15/ 3161-66 900' oilin 14 hr. 3000 A FV/ 110 bopdComp. 333 bopd 6% water

J. E. TYRA

Map No. _____ Sec. 14 Twp. 19 R. 12W

Well No. 1 Gill

Aledo & Murfin Company

Murfin Drlg. Contractor

NW SW NE

_____ Ft. from N. Line

990 Ft. from S. Line

_____ Ft. from E. Line

330 Ft. from W. Line

SECTION PLAT



Barton County

Sohio farmout

Location _____

Rig up X

Drilling and Remarks:

RECORD

Cased _____ in., _____ ft.

Sand _____

Gas _____

Oil _____

Total Depth _____

PRODUCTION

1st 24 hrs. Nat. _____

1st 24 hrs. after shot _____

Gas _____ Cu. Ft.

Dry Hole _____

Abandoned _____

Date

JUN 28 1950 19

J. E. TVDA Scout