


Section 14 Township 19 Range 12 W

Well No. # 2 Gill

Company Murfin & Aledo

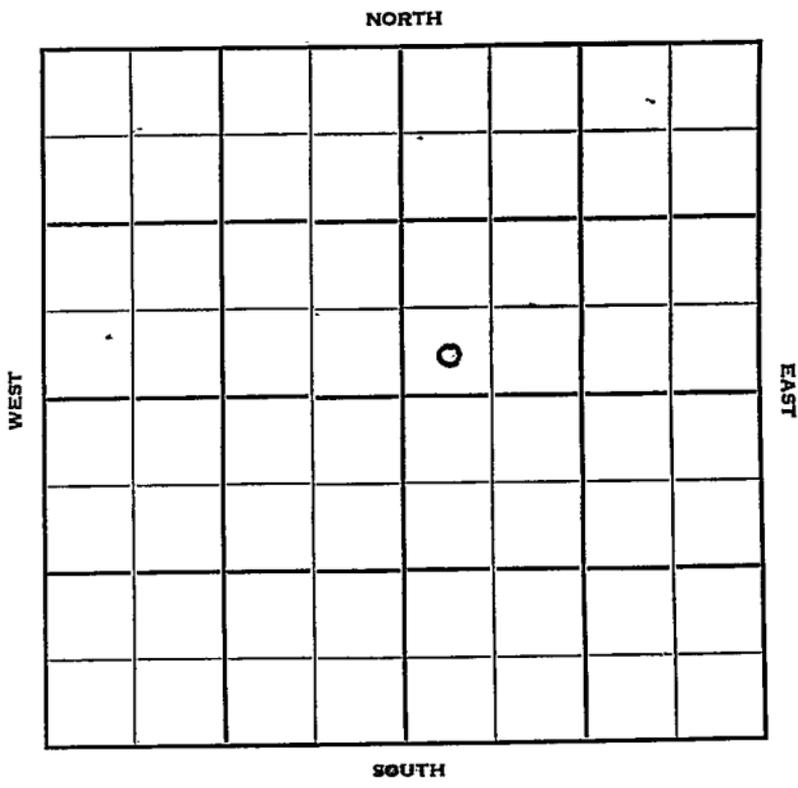

Barton

KANSAS

Sec. 14 Twp. 19 R. 12W

Well No. #2 Gill Farm


Murfin & Aledo Company

Murfin Drlg. - Contr. Contractor

North Hammer Pool

NORTH

 Ft. from N. Line

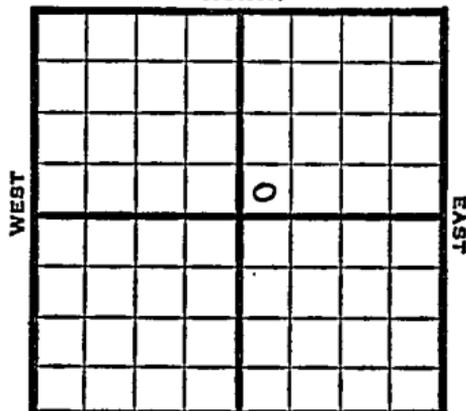

330' Ft. from S. Line

 Ft. from E. Line

330' Ft. from W. Line

SW SW NE

1951

Elev. 1849' REPORT

2/7

Location

3/7

Spud 2-7-51
D&A TD 3446
8" @ 209'
Anhy 669-75 Top. 2762
Heeb. 3016 Br lime 3133
Lans. 3150
DST 3152-3211 opn 50 min.
Rec. 25' socm
DST 3285-67 opn 1 hr Rec. 57' wcm
Arb/ 3435 SO 3421-46
5" @ 3418
TD 3446 D&A

ABANDONED

