


Section 14 Township 19 Range 12-W

Well No. #3 Scharz

Company Aladdin Pet.

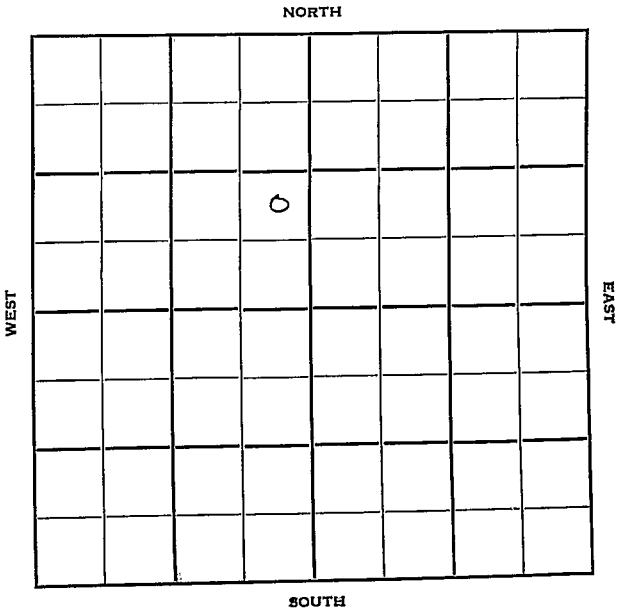

Sec. 14 Twp. 19 R. 12W

Well No. #3 Schartz Farm

Aladdin Petroleum Company

Crowe Contractor

SW Cheyenne


_____ Ft. from N. Line

990' _____ Ft. from S. Line

330' _____ Ft. from E. Line

_____ Ft. from W. Line

NE SE NW

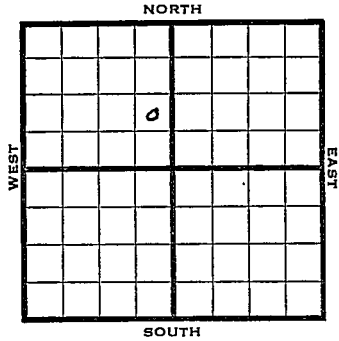

1950 Elev 1846 REPORT

8/9 Location

10/4 Spud 8-24-50

8 5/8" @ 242

Anhy 670

Lans 3132

DST 3137-3210 opn 15 min rec 350' oil cut mud

1200' gassy oil

DST 3278-3320 opn 1 hr rec 60' socm

Arb 3400

5" @ 3403

TD 3431

18 go 1 hr

1000 A

2 1/2 boph PB 3386

24/3308-16, 15/3303-08, 24/3198-3209

2000' oil 2 1/2 hr

41/3176-90, 36/3154-64, 26/3143-52

33/3129-40 3000 A Comp 346 bopd

7% water

Completed TD 3431

COMPLETED

