



Sec. 14 Twp. 19 R. 12W

Well No. #2 Schartz Farm

Aladdin & Crowe Company

Contractor

Cheyenne View


Ft. from N. Line

330' Ft. from S. Line

Ft. from E. Line

330' Ft. from W. Line

SW SW NW

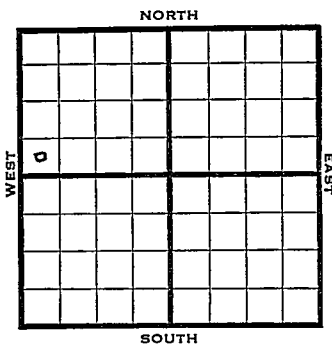

1950

Elev 1847

REPORT

4/26

Spud 4-23-50  
8" @ 230'  
Drlg. 415'

5/24

8" @ 230  
Anhy 635-70  
Heebner 3009  
Br lime 3123  
Lans 3141  
DST 3143-3215  
open 1 hr, rec 1020' ocm  
Cong 3408-64  
8" @ 3463½  
25/3205-14  
3000 acid  
4/3180-94  
32/3258-70  
49/3132-50.  
flow 122 bo 2 hr  
Comp 844 hpd  
Completed  
TD 3464

**COMPLETED**

Map No. \_\_\_\_\_ Sec. 14 Twp. 19 R. 12W

Well No. 2 Schartz

Aladdin & Crowe Company

Contractor

SWSW NW


\_\_\_\_\_ Ft. from N. Line

330 Ft. from S. Line

\_\_\_\_\_ Ft. from E. Line

330 Ft. from W. Line

SECTION PLAT

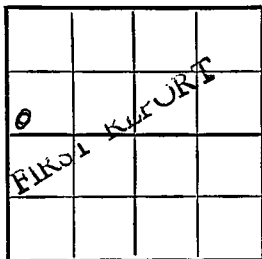

Barton County

Location \_\_\_\_\_

Rig up \_\_\_\_\_

Drilling and Remarks:

Spud 4-23-50

8" @ 230

drlg. 415

RECORD

Cased \_\_\_\_\_ in., \_\_\_\_\_ ft.

Sand \_\_\_\_\_

Gas \_\_\_\_\_

Oil \_\_\_\_\_

Total Depth \_\_\_\_\_

PRODUCTION

1st 24 hrs. Nat. \_\_\_\_\_

1st 24 hrs. after shot \_\_\_\_\_

Gas \_\_\_\_\_ Cu. Ft.

Dry Hole \_\_\_\_\_

Abandoned \_\_\_\_\_

Date

APR 26 1950 19

J. E. TYRA Scout



Kansas

Map No. \_\_\_\_\_ Sec. 14 Twp. 19 R. 12W

Well No. 2 Scharzt

Aladdin & Crowe Company

\_\_\_\_\_ Contractor  
 FW SW NW El. 1847

SECTION PLAT

\_\_\_\_\_ Ft. from N. Line

330 Ft. from S. Line

\_\_\_\_\_ Ft. from E. Line

330 Ft. from W. Line

		o	
COMPLETE			

Barton

Location \_\_\_\_\_

Rig up \_\_\_\_\_

Drilling and Remarks:

*8" @ 230  
 anhy 635-70  
 Neel Per 3009  
 Br. line 3123  
 Lams. 3141  
 DST. 3143-3215  
 open 1 hr.*

RECORD

Cased \_\_\_\_\_ in., \_\_\_\_\_ ft.

Sand \_\_\_\_\_

Gas \_\_\_\_\_

Oil \_\_\_\_\_

Total Depth 3464

PRODUCTION

1st 24 hrs. Nat. \_\_\_\_\_

1st 24 hrs. after shot \_\_\_\_\_

Gas \_\_\_\_\_ Cu. Ft.

Dry Hole \_\_\_\_\_

Abandoned \_\_\_\_\_

Date

MAY 24 1950

19

J. E. TYRA Scout

