


KANSAS

Barton

Section 14 Township 19 Range 12-W

Well No. #1 Schartz

Company Aladdin Pet. etal
Wildcat

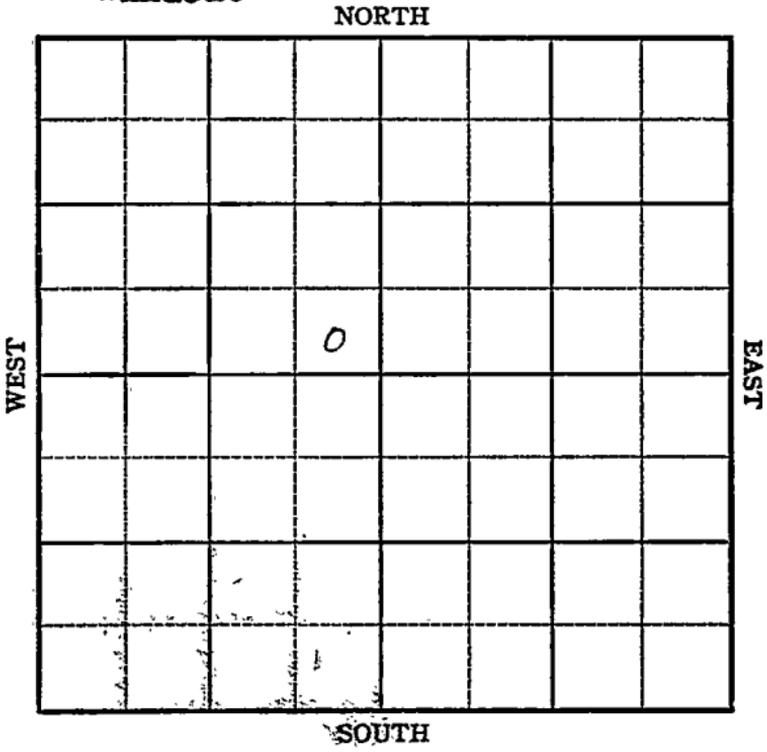


Sec. 14 Twp. 19 R. 12W

Well No. #1 Schartz Farm
Aladdin Pet. et al Company
Crow Drlg. Contractor

Wildcat

 Ft. from N. Line
330' Ft. from S. Line
330' Ft. from E. Line
 Ft. from W. Line

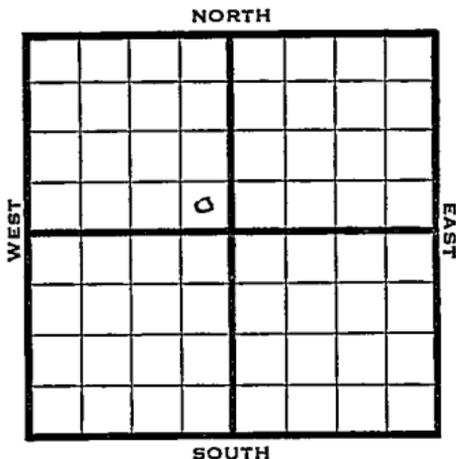

SE NW

1949 Elev 1851' REPORT

10/26 8" @ 240'
 Drlg. 410'
 11/1 Lansing 3143'
 Drlg. 3275'
 11/9 Arbuckle 3427'
 5" @ 3428'
 TD 3430'
 Acid 1000
 11/16 TD 3431'
 46 cone shots 3428-30
 2000 acid W
 TD 3455' PB
 11/23 "
 11/30 TD 3455'
 Lansing 3143'
 Arb. 3427'
 5" @ 3428'
 1500 acid
 Pump 198 Oil Pot
 40° Gr.
 Comp

COMPLETED

Map No. _____ Sec. 14 Twp. 19 R. 12W

Well No. 1 Schartz

Aladdin Pet. etal. Company

Crow Drlg. Contractor

SE NW

FIRST REPORT
 SECTION PLAT

_____ Ft. from N. Line

330 Ft. from S. Line

330 Ft. from E. Line

_____ Ft. from W. Line

Barton County

Location _____

Rig up _____

Drilling and Remarks:

8" @ 240

drlg. 410

RECORD

Cased _____ in., _____ ft.

Sand _____

Gas _____

Oil _____

Total Depth _____

PRODUCTION

1st 24 hrs. Nat. _____

1st 24 hrs. after shot _____

Gas _____ Cu. Ft.

Dry Hole _____

Abandoned _____

Date

OCT 26 1949 19

S. J. LEWIS Scout

Kansas

Map No. _____ Sec. 14 Twp. 19 R. 12W

Well No. 1 Scharztz

Aladdin Pet. etal. Company

COMPLETE

Contractor

SE NW

E 11851

SECTION PLAT

_____ Ft. from N. Line

330 Ft. from S. Line

330 Ft. from E. Line

_____ Ft. from W. Line

Barton County

Location _____

Rig up _____

Drilling and Remarks:

Line 3142
Co. 2427
5" 03425
1500000
Ping 198 oil RT
480 ft.

RECORD

Cased _____ in., _____ ft.

Sand _____

Gas _____

Oil _____

Total Depth 3455

PRODUCTION

1st 24 hrs. Nat. _____

1st 24 hrs. after shot _____

Gas _____ Cu. Ft.

Dry Hole _____

Abandoned _____

Date

NOV 30 1949 19

S. J. LEWIS Scout