


Barton

KANSAS

SECTION 14 TOWNSHIP 19S RANGE 11W

WELL NO. #1 Weber

COMPANY Nadel-Gussman

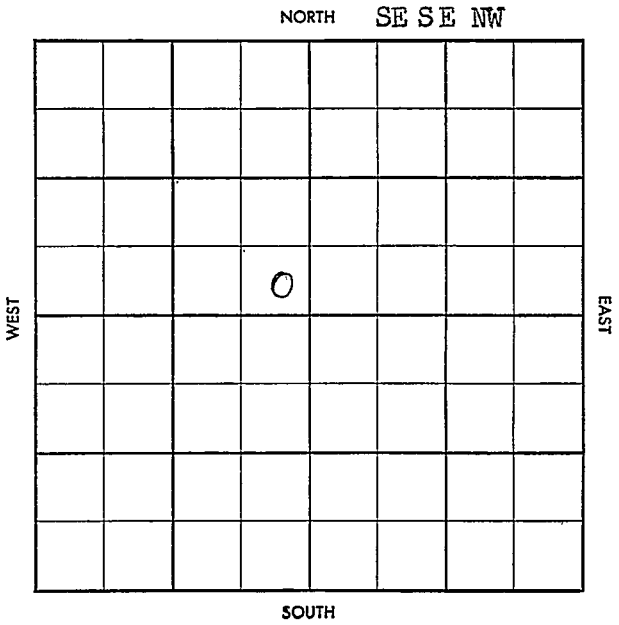

CO. ~~Barton~~ ELEV. \_\_\_\_\_SEC. 14 TWP. 19 RGE. 11WCOMPANY Nadel-Gussman NO. 111

|  |  |  |  |
|--|--|--|--|
|  |  |  |  |
|  |  |  |  |
|  |  |  |  |
|  |  |  |  |

OCT 2 57

FARM WeberLOC. SE SE NW

|       |     |
|-------|-----|
| Tops  |     |
| Anhy. | 548 |
|       |     |
|       |     |
|       |     |
|       |     |
|       |     |
|       |     |
|       |     |

GEOL. \_\_\_\_\_

CONTR. Reserve Drlg. ToolsPOOL EberhardtSPUD 9-26-578" @ 327 w/250, drlg.  
2410

CO.

LSE.

NO.

SEC.

TWP.

RGE.

S-513-A

CO. BartonELEV. 1280

OCT 9 '57

SEC. 14 TWP. 19 RGE. 11WCOMPANY Nadel-Gussman NO. 1

ABANDONED

FARM WeberLOC. SE SE NW

| Tops  |        |
|-------|--------|
| Anhy. | 548    |
| H     | 2926   |
| B     | 3044   |
| L     | 3059   |
| Cher  | C 3346 |
|       |        |
|       |        |
|       |        |
| TD    | 3400   |

GEOL.

CONTR. Reserve Drlg. ToolsPOOL EberhardtSPUD 9-26-57

8" @ 327 w/250, drlg.

2410 OC. - D5T

3068 - 92 45'

5' M AHPD

no log

J &amp; A