

Well No. #1 Eberhardt

Company Grow Drlg.

Eberhardt Pool
NORTH

WEST

EAST

SOUTH

0

KANSAS

Barton

✓
11W

Sec. 14 Twp. 19 R. 11W

Well No. #1 Eberhardt Farm

Crow Drlg.

Company

Eberhardt Pool


990' Ft. from N. Line

Ft. from S. Line

Ft. from E. Line

990' Ft. from W. Line

SE NW SE

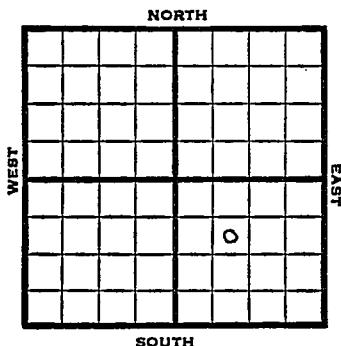

1948

Li 1779'

REPORT

12/8

Lans. 3055'

Drlg. 3062'

12/15

TD 3363'

Arb. 3337'

Aband.

ABANDONED

Map No. _____ Sec. 14 Twp. 19 R. 11W

Well No. 1 Eberhardt

Crow Drlg. Company

FIRST REPORT Contractor

SE NW SE


SECTION PLAT

990 Ft. from N. Line

_____ Ft. from S. Line

_____ Ft. from E. Line

990 Ft. from W. Line

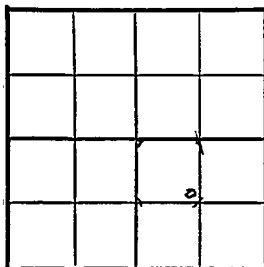

Barton County

Location _____

Rig up _____

Drilling and Remarks:

Lans. 3055

drlg. 3062

RECORD

Cased _____ in., _____ ft.

Sand _____

Gas _____

Oil _____

Total Depth _____

PRODUCTION

1st 24 hrs. Nat. _____

1st 24 hrs. after shot _____

Gas _____ Cu. Ft.

Dry Hole _____

Abandoned _____

Date

DEC 8 1943 19

S. J. LEWIS Scout

Kansas

Map No. 46 Sec. 14 Twp. 19 R. 11WWell No. 1 Eberhardt

Crow Drlg.

Company

ABANDONED

Contractor

SE NW SE

E11779
SECTION PLAT990 Ft. from N. Line Ft. from S. Line Ft. from E. Line990 Ft. from W. Line

		8	
1			

Barton County

Location

Rig up

Drilling and Remarks:

Core 3337

RECORD

Cased in., ft.Sand Gas Oil Total Depth 396.9

PRODUCTION

1st 24 hrs. Nat. 1st 24 hrs. after shot Gas Cu. Ft.Dry Hole Abandoned

Date

DEC 15 1942. 19

S. J. LEWIS

Scout