


Section 14 Township 19 Range 11-W

Well No. #2 Eberhardt

Company Stanolind

Eberhardt Pool

NORTH

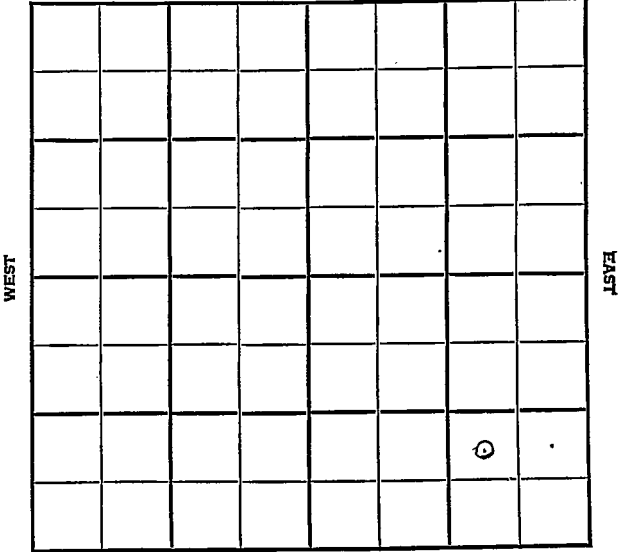

SOUTH

Sec. 14 Twp. 19 R. 11W

Well No. #2 Eberhardt Farm

Stanolind Company


Eberhardt Pool

           Ft. from N. Line

990' Ft. from S. Line

990' Ft. from E. Line

           Ft. from W. Line

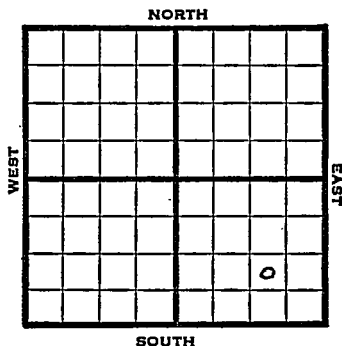

NW SE SE

1948 Eli 1779' REPORT

- 5/26 RUR
- 6/1 10" @ 522'  
Drig. - 1833'
- 6/9 Lansing 3033'  
Dig 3264'
- 6/16 Arbuckle 3340'  
7" @ 3310'  
Plug 3120 - 96 shots 3036-60  
500 acid
- 6/23 4000 acid  
200,000 Gas  
TD 3345'
- 6/29 2000 acid
- 7/8 "
- 7/14 "
- 7/21 "
- 7/28 "
- 8/4 Lansing 3033'  
Arb. 3310'  
TD 3345'  
7" @ 3310'  
5000 acid  
Bump 60 oil Pot  
409 Gr.  
Comp

**COMPLETED**

Map No. \_\_\_\_\_ Sec. 14 Twp. 19 R. 11W

Well No. 2 Eberhardt

Stanolind Company

**FIRST REPORT** Contractor

NW SE SE

\_\_\_\_\_ Ft. from N. Line

990 Ft. from S. Line

990 Ft. from E. Line

\_\_\_\_\_ Ft. from W. Line

SECTION PLAT

			a

Barton County

Location \_\_\_\_\_

Rig up \_\_\_\_\_

Drilling and Remarks:

R U R

RECORD

Cased \_\_\_\_\_ in., \_\_\_\_\_ ft.

Sand \_\_\_\_\_

Gas \_\_\_\_\_

Oil \_\_\_\_\_

Total Depth \_\_\_\_\_

PRODUCTION

1st 24 hrs. Nat. \_\_\_\_\_

1st 24 hrs. after shot \_\_\_\_\_

Gas \_\_\_\_\_ Cu. Ft.

Dry Hole \_\_\_\_\_

Abandoned \_\_\_\_\_

Date

MAY 26 1948 19 \_\_\_\_\_ S. J. LEWIS Scout

Barton County Kansas State

Map No. 46 Sec. 14 Twp. 19 R. 11W

Well No. 2 Eberhardt

Stanolind Company

**COMPLETE**

Contractor

NW SE SE

*E 11779*  
SECTION PLAT

\_\_\_\_\_ Ft. from N. Line

990 Ft. from S. Line

990 Ft. from E. Line

\_\_\_\_\_ Ft. from W. Line


**Eberhardt Pool**

Remarks:

*Louis 8032*  
*Ar 73310*  
*7173345*  
*7" @ 3310*  
*5000 acid*  
*Pump. 60 oil Pot*  
*40 2/3*

Date  
AUG. 4 1948

Scout **S. J. LEWIS**