


KANSAS

FORM 51 25M 3-49 PETROL Barton

Section 14 Township 19 Range 11W

Well No. #3 Eberhart

Company Fell & Wolfe

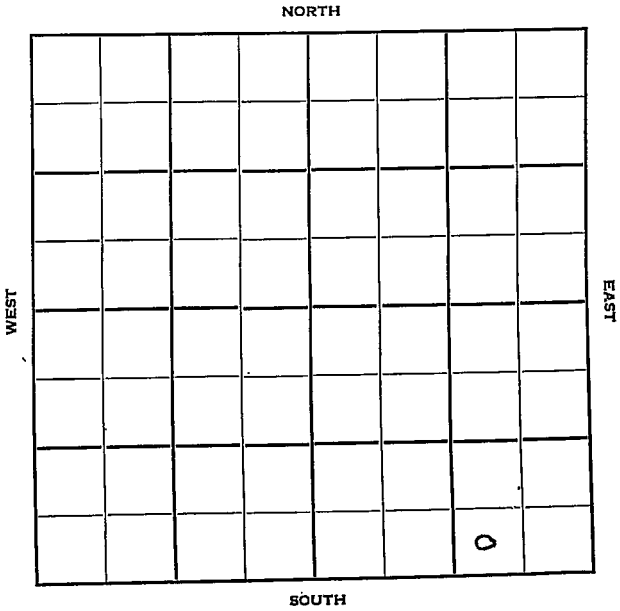

Barton

KANSAS

Sec. 14 - Twp. 19 R. 11W

Well No. #3 Eberhart Farm

Fell & Wolfe Company

Edwards Drlg. Contractor


Ft. from N. Line

330 Ft. from S. Line

990 Ft. from E. Line

Ft. from W. Line

SE $\frac{1}{4}$ SW SE SE

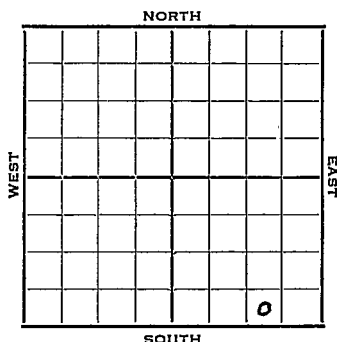

1952 Elev. 1780' REPORT

10/22 Spud 10-19-52
8" @ 250'
Drlg. 1334'

10/29 Topeka 2643, Heeb 2902, Tor 2922,
Br li 3022, Lans 3040
DST 3042-50, $\frac{1}{2}$ hr., 10' gcm
DST 3060-71 $\frac{1}{2}$ hr., 10' m
Cong 3312, Arb 3335
circu @ 3347'

11/5 Spud 10-19-52
D&A TD 3380 8" @ 250
Top. 2643 Heeb. 2902
Tor. 2922 Br Li 3022
Lans. 3040
DST 3042-50 open $\frac{1}{2}$ hr. rec. 10' gcm
DST 3060-71 open $\frac{1}{2}$ hr. rec. 10' mud
O# Cong. 3312
Arb. 3335' TD 3380' D&A

ABANDONED

County Barton State Kansas

Sec. 14 (Blk. 19 (Sur. 117 Map No. _____
Twp.) Rge.)

Operator Felt & Wolfe

Well No. 3 Farm Eberhart

Elev.	Location	SE	SE	SE
-------	----------	----	----	----

FIRST REPORT

330 Ft. From S Line SE

Qtr	Ft. From	E	Line	Quarter
-----	----------	---	------	---------

1st. Report OCT 22 1952

Completion

Remarks

Edwards Delg. - Contd.

Spudding Date 10-19-52

Drlg. Data


8" @ 250 drlg. 1334

County Barton State Kansas
 Sec. 14 (Blk.) 19 (Sur.) 11W Map No.

Operator Fell & Wolfe

Well No. 3 Farm Eberhart

Elev. 1780 Location SW SE SE

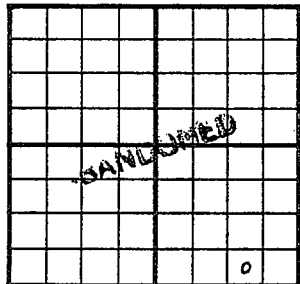

330 Ft. From S Line SE

990 Ft. From E Line Quarter

Ist. Report

Completion NOV 5 1952

Remarks

Edwards Drlg. - Contr.

Spudding Date 10-19-52

Drlg. Data D & A TD 3380

8" @ 250 Top. 2643 Heeb. 2902

Tor. 2922 Br. lime 3022 Lans. 3040

DST 3042-50 open $\frac{1}{2}$ hr. Rec. 10' gcm

DST 3060-71 open $\frac{1}{2}$ hr. Rec. 10' mud

0# Cong. 3312 Arb. 3335 TD 3380

D & A

J. G. McGEHEE