

KANSAS

Form 51—5M—11-38—Palace

Barton

Section 14 Township 19 Range 11-W

Well No. #1 Petz


Company Claude Drilling et al

NORTH

Silica Pool

WEST

EAST

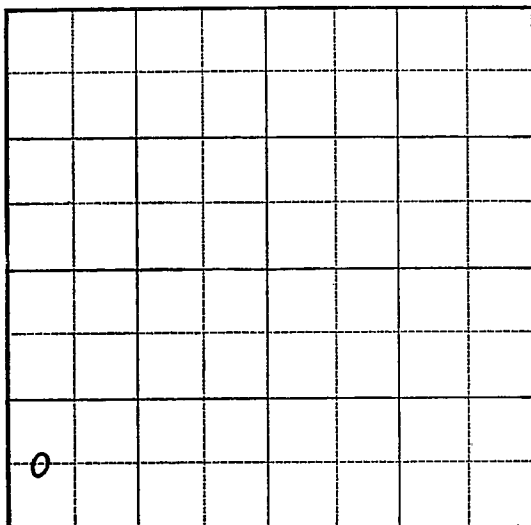

SOUTH

Barton

KANSAS


Map No. _____ Sec. 14 Twp. 19 R. 11WWell No. 1 PetzClaude Drilling etal Company

Contractor

FIRST REPORT

C $W\frac{1}{2}$ SW SW

SECTION PLAT

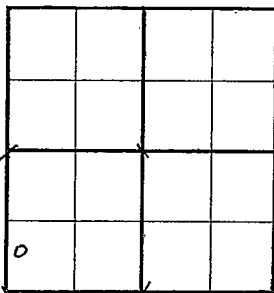

_____ Ft. from N. Line

660 Ft. from S. Line330 Ft. from E. Line

_____ Ft. from W. Line

SILICA POOL

Location _____

Rig up _____

Drilling and Remarks:

Rotary

RECORD

Cased _____ in., _____ ft.

Sand _____

Gas _____

Oil _____

Total Depth _____

PRODUCTION

1st 24 hrs. Nat. _____

1st 24 hrs. after shot _____

Gas _____ Cu. Ft.

Dry Hole _____

Abandoned _____

Date

OCT 4 1939

19

S. I. LEWIS

Scout

Barton


KANSAS

Map No. 46 Sec. 14 Twp. 19 R. 11WWell No. 1 petzClaude Drilling etal Company

Contractor

ABANDONED
C $W\frac{1}{2}$ SW SW

SECTION PLAT

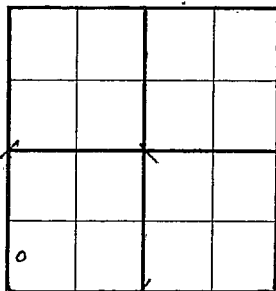 Ft. from N. Line660 Ft. from S. Line330 Ft. from E. Line Ft. from W. Line

SILICA POOL

Location Rig up

Drilling and Remarks:

Cor 3420
No shows

RECORD

Cased in., ft.Sand Gas Oil Total Depth 3471

PRODUCTION

1st 24 hrs. Nat. 1st 24 hrs. after shot Gas Cu. Ft.Dry Hole Abandoned

Date

NCV 3 1939 19 J. LEWIS Scout