


Section 14 Township 19 Range 11WWell No. #2 PetzCompany Alpine Oil

NORTH

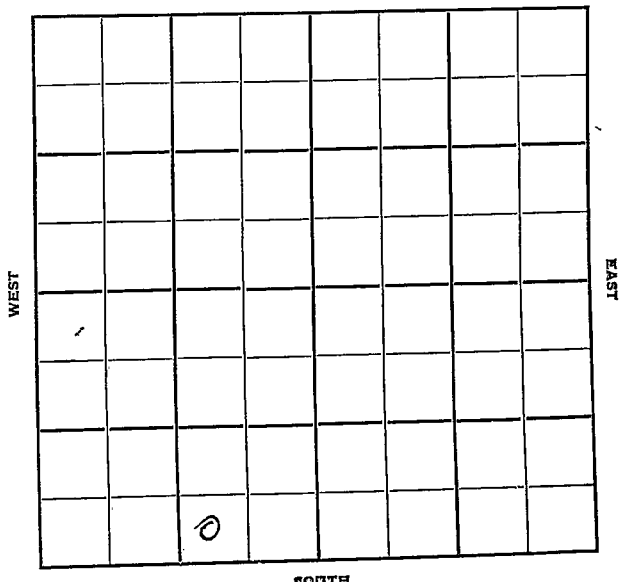

SOUTH

Barton

Sec. 14 Twp. 19 R. KANSAS 11W

Well No. #2 Petz Farm

Alpine Oil Company

Quaker - Contr. Contractor


 Ft. from N. Line

330' Ft. from S. Line

990' Ft. from E. Line


 Ft. from W. Line

SW SE SW

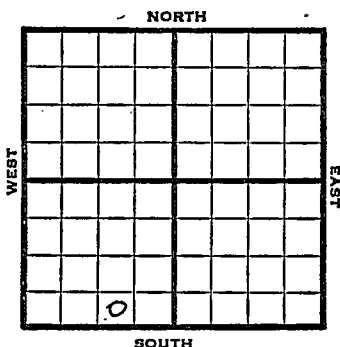

1951	Elv. 1779' REPORT
10/24	Spud 10-12-51 8" @ 222' Drlg. 1840'
11/28	Spud. 10-12-51 Oil Well TD 3340 8" @ 222 Heeb. 2910 Br Lime 3028 Lans. 3042 Cong. 3318-40 5" @ 3338 40/3131-40 1350 A S/5 boph Comp. 25 bopd
	COMPLETED

J. E. TYRA

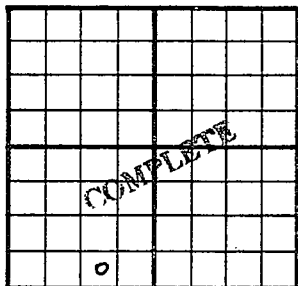County Barton State KansasSec. 14 (Blk.) 19 (Sur.) 11W Map No.Operator Alpine OilWell No. 2 Farm PetzElev. 1779 Location SW SE SW330 Ft. From S Line SW990 Ft. From E Line Quarter1st. ReportCompletion NOV 28 1951RemarksQuaker Drlg. - Contr.Spudding Date 10-12-51Drlg. Data Oil well TD 33408" @ 222 Heeb. 2910 Br. line 3028Lens. 3042 Cong. 3318-40 5" @ 333840/ 3131-40 1350 A S/ 5 bophComp. 25 bopd

J. E. TYRA