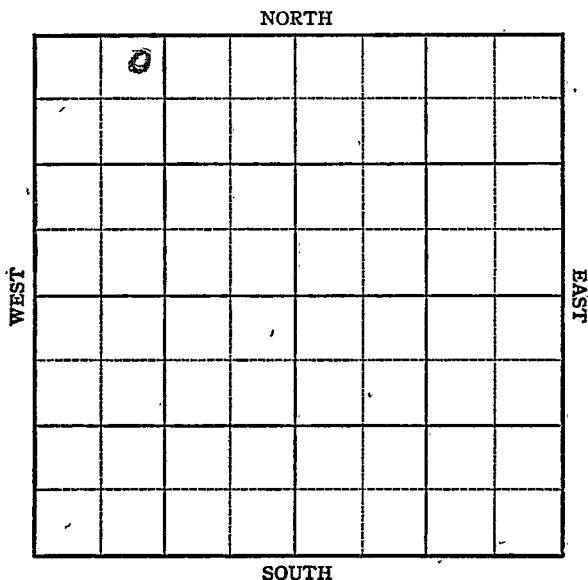


KANSAS

Barton county

Section 14 Township 19 Range 11-WWell No. #1 Webber

(Weber)

Company Three Way Drlg

KANSAS

Barton

Sec. 14 Twp. 19 R. 11-W ✓

Well No. #1 Weber Farm

Three Way Drlg Company
Silica Pool


330 Ft. from N. Line

 Ft. from S. Line

 Ft. from E. Line

990 Ft. from W. Line

NE NW NW

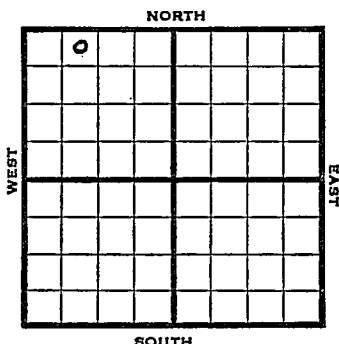

1947 Elev. 1782 REPORT

1/29 R U R

2/5 8" @ 178'
Anhydrite 570'
Drlg 2350'

2/12 Lans 3078'
Cong 3364'
Drlg 3390'

2/19 Arb 3448
TD 3462'

ABANDONED

Map No. 46 Sec. 14 Twp. 19 R. 11W

Well No. 1 Weber

Three way Drlg. Company

FIRST REPORT Contractor

NE NW NW


SECTION PLAT

330 Ft. from N. Line

 Ft. from S. Line

 Ft. from E. Line

990 Ft. from W. Line

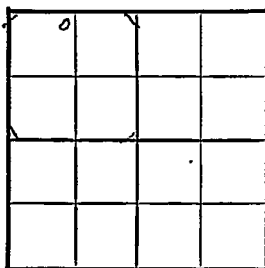

Barton County

Location

Rig up

Drilling and Remarks:

R U R

RECORD

Cased in., ft.

Sand

Gas

Oil

Total Depth

PRODUCTION

1st 24 hrs. Nat.

1st 24 hrs. after shot

Gas Cu. Ft.

Dry Hole

Abandoned

Date

JAN 29 1947 19 S. J. LEWIS Scout

Map No. 46 Sec. 14 Twp. 19 R. 11W

Well No. 1 Weber

Three way Drlg. Company

ABANDONED

Contractor E. H. 1782

NE NW NW


SECTION PLAT

330 Ft. from N. Line

Ft. from S. Line

Ft. from E. Line

990 Ft. from W. Line

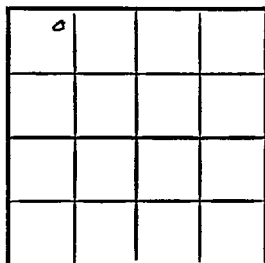

Barton County

Location

Rig up

Drilling and Remarks:

Per 13448

RECORD

Cased in., ft.

Sand

Gas

Oil

Total Depth 3462

PRODUCTION

1st 24 hrs. Nat.

1st 24 hrs. after shot

Gas Cu. Ft.

Dry Hole

Abandoned

• Date

FEB 19 1947

S. J. LEWIS

Scout