

KANSAS

Rice

FORM 51 IOM 12-46 PETROL

Section 14 Township 19 Range 10-W

Well No. 4 Ankerholtz

Company C. H. Weaver

Silica Pool

NORTH

WEST

EAST

o							

SOUTH

KANSAS Rice

Sec. 14 Twp. 19 R. 10W

Well No. #4 Ankerholtz Farm

C. H. Weaver Company

Silica


330 Ft. from N. Line

 Ft. from S. Line

 Ft. from E. Line

330 Ft. from W. Line

NW/c

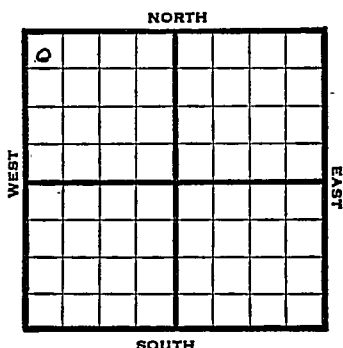

1947 Elev. 1751' REPORT

9/24 RUR

10/1 8" @ 152'
Drlg. 2555'

10/8 "

10/15 Lansing 2937'
BKG 5204'
Arbuckle 3274'
TD 3278'
5" @ 3277'
RUST

10/22 75 shots 3144-51
CO

10/29 Acid 2000
Swb 30 bbls oil 1PH, 3 hrs.

11/5 "

11/12 "

11/19 "

11/25 "

12/3 Arb. 3274'
5" @ 3277'
Lans. 2937'
Perf Lans.
Acid 200
Pump 263 Pot
Gr. 420
Total Depth 3278'
COMPLETED

Map No. _____ Sec. 14 Twp. 19 R. 10W

Well No. 4 Ankerholtz

C. H. Weaver Company

FIRST REPORT Contractor

NW/C

SECTION PLAT

330 Ft. from N. Line

_____ Ft. from S. Line

_____ Ft. from E. Line

330 Ft. from W. Line

0			

Rice County

Location _____

Rig up _____

Drilling and Remarks:

R U R

RECORD

Cased _____ in., _____ ft.

Sand _____

Gas _____

Oil _____

Total Depth _____

PRODUCTION

1st 24 hrs. Nat. _____

1st 24 hrs. after shot _____

Gas _____ Cu. Ft.

Dry Hole _____

Abandoned _____

Date

SEP 24 1947 19 S. J. LEWIS Scout

Wm

Small Maps	<i>Wm</i>
Star 5	<i>Wm</i>
Tracing	
France Map	<i>Wm</i>
Scarborough Map	<i>Wm</i>
Pierce Map	
Geological Dept.	
Pierce Plat Book	

Map No. 46 Sec. 14 Twp. 19 R. 10W

Well No. 4 Ankerholtz

C. H. Weaver Company

COMPLETE

Contractor

NW/C

E11251
SECTION PLAT

330 Ft. from N. Line

 Ft. from S. Line

 Ft. from E. Line

330 Ft. from W. Line

4			

Rice County

Location

Rig up

Drilling and Remarks:

Per 3274
5' C 3277
Lane 287
Per Lane
200 acid
Pump 268 Pot.
42 2 1/2

RECORD

Cased in., ft.

Sand

Gas

Oil

Total Depth 3278

PRODUCTION

1st 24 hrs. Nat.

1st 24 hrs. after shot

Gas Cu. Ft.

Dry Hole

Abandoned

Date

DEC 3 1947

19

S. J. LEWIS

Scout

[Handwritten signature]

Small Maps	<i>[initials]</i>
s	<i>[initials]</i>
ing	<i>[initials]</i>
ance Map	<i>[initials]</i>
arborough Map	<i>[initials]</i>
erce Map	<i>[initials]</i>
ecological Dept.	
erice Plat Book	