

KANSAS

Rice


FORM 51 IOM 12-46 PETROL

Section 14 Township 19 Range 10-W

Well No. 2 Feldman "B"

Company Skelly

Silica Pool

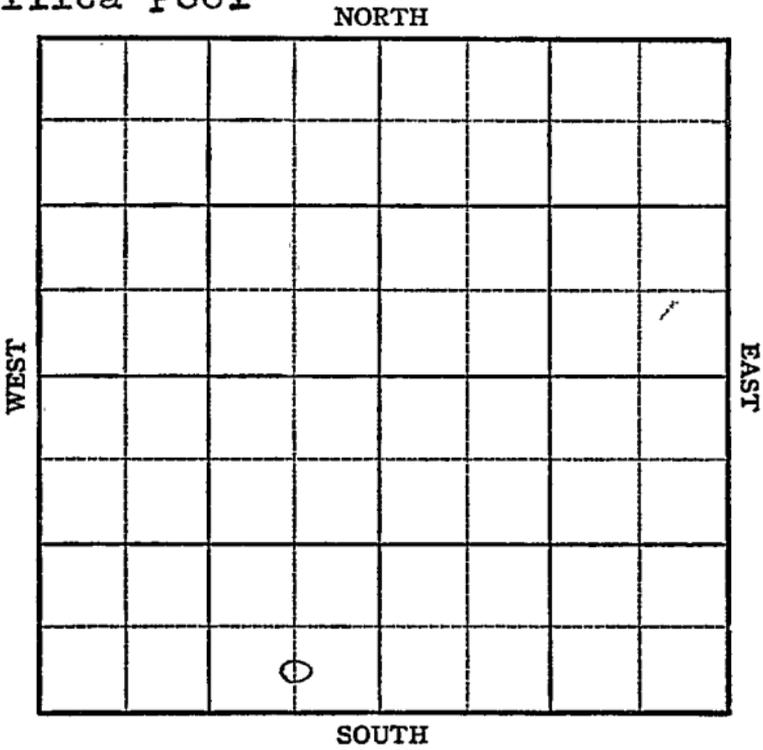



Sec. 14 Twp. 19 R. 10W

Well No. #2 Feldman "B" Farm

Skelly Company


Silica

 Ft. from N. Line

330 Ft. from S. Line

660 Ft. from E. Line

 Ft. from W. Line

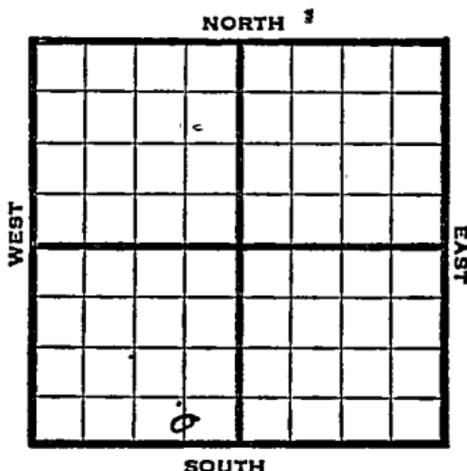

C SL SE SW

1947	Elev. 1748 REPORT
10/1	Location
10/8	8 " @ 430' WOO
10/15	Fsg. 2192'
10/22	Drlg. 2800'
10/29	Drlg. 3093'
11/5	Lansing 2953' Arbuckle 3262' TD 3268' 5" @ 3264' RUST
11/12	TD 3283' - 500 acid. Swb. 122 bbls. oil in 14 hrs.
11/25	Arbuckle 3262 5" @ 3264 500 Acid Pot Pump 281 Pot. TD 3283 Gravity 42
COMPLETED	

Map No. _____ Sec. 14 Twp. 19 R. 10W

Well No. 2 Feldman "B"

Skelly Company

FIRST REPORT

Contractor

C S L SE SW

SECTION PLAT

_____ Ft. from N. Line

330 Ft. from S. Line

660 Ft. from E. Line

_____ Ft. from W. Line

Rice County

Location X

Rig up _____

Drilling and Remarks:
f

RECORD

Cased _____ in., _____ ft.

Sand _____

Gas _____

Oil _____

Total Depth _____

PRODUCTION

1st 24 hrs. Nat. _____

1st 24 hrs. after shot _____

Gas _____ Cu. Ft.

Dry Hole _____

Abandoned _____

Date

OCT 1 1947

19

S. J. LEWIS

Scout

Kansas

Map No. 46 Sec. 14 Twp. 19 R. 10WWell No. 2 Feldman "B"Skelly Company

COMPLETE

Contractor

C S L SE SW

E. 11747
SECTION PLAT Ft. from N. Line330 Ft. from S. Line660 Ft. from E. Line Ft. from W. Line

Rice County

Location Rig up

Drilling and Remarks:

Cor 832625' @ 3264500 acidPump 25/2842 1/2

RECORD

Cased in., ft.Sand Gas Oil Total Depth 223

PRODUCTION

1st 24 hrs. Nat. 1st 24 hrs. after shot Gas Cu. Ft.Dry Hole Abandoned

Date

NOV 25 1947

19

S. J. LEWIS

Scout