

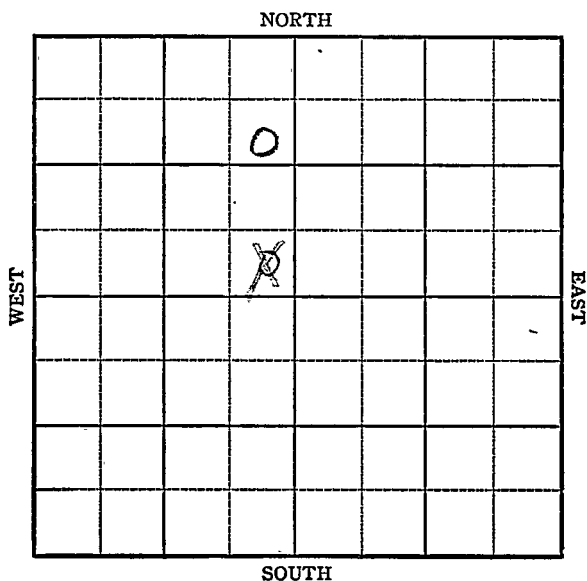
KANSAS

Rice County

FORM 51 5M PETROL

Section 14 Township 19 Range 10W

2

Well No. -1 AnkerholzCompany G. H. Weaver

KANSAS

Rice

Sec. 14 Twp. 19 R. 10W

Well No. #2 1 Ankerholz Farm

C. H. Weaver Company

Silica

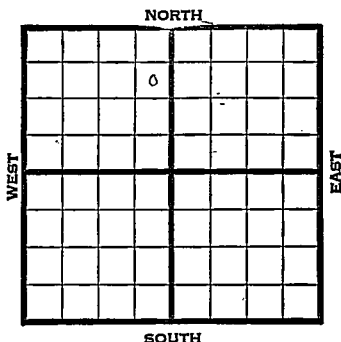
990 Ft. from N. Line

Ft. from S. Line

330 Ft. from E. Line

Ft. from W. Line

SE NE NW



1945

Elev. 1750' REPORT

6/6

8" -148

2040

6/14

Arb 3285'

TD 3287

5" @ 3285 RUST

6/23

TD 3291

swb 8 oil PH 4 hrs

7/3

Arb. 3285

5" @ 3285

TD 3291'

Pump 405 Pot.

Grav. 42.7

COMPLETED

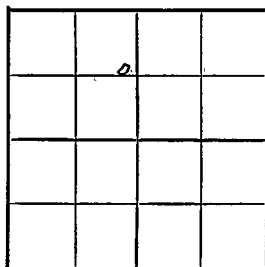
KANSAS
KansasPool Name SilicaMap No. 46 Sec. 14 Twp. 19 R. 10WWell No. 2 AnkerholzC. H. Weaver

Company

COMPLETED

Contractor

SE NE NW

E/1750
SECTION PLAT990 Ft. from N. Line Ft. from S. Line330 Ft. from E. Line Ft. from W. Line

Rice County

Location Rig up

Drilling and Remarks:

Cer 102 855' 102 85Pump 405 P 242 2/3**RECORD**Cased in., ft.Sand Gas Oil Total Depth 328 1/4**PRODUCTION**1st 24 hrs. Nat. 1st 24 hrs. after shot Gas Cu. Ft.Dry Hole Abandoned

Date

JUL 3 194519S. J. LEWIS Scout

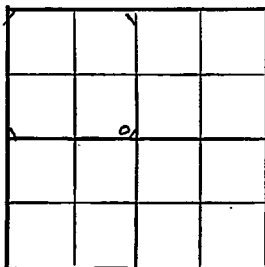
Kansas Pool Name SilicaMap No. 46 Sec. 14 Twp. 19 R. 10WWell No. 1 AnkerholzC. H. Weaver Company

FIRST REPORT

Contractor

SE NW

SECTION PLAT

 Ft. from N. Line330 Ft. from S. Line330 Ft. from E. Line Ft. from W. LineRice CountyLocation Rig up

Drilling and Remarks:

8 - 147 WOC

RECORD

Cased in., ft.Sand Gas Oil Total Depth

PRODUCTION

1st 24 hrs. Nat. 1st 24 hrs. after shot Gas Cu. Ft.Dry Hole Abandoned

Date

MAY 23 1945 19S. J. LEWIS

Scout

Kansas Pool Name SilicaMap No. 46 Sec. 14 Twp. 19 R. 10WWell No. 2 AnkerholzC. H. Weaver

Company

CORRECTION

Contractor

SE NE NW

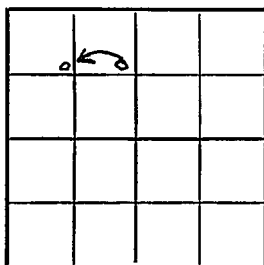
SECTION PLAT

990 Ft. from N. Line

Ft. from S. Line

330 Ft. from E. Line

Ft. from W. Line

Rice County

Location _____

Rig up _____

Drilling and Remarks:

reported as
#1 Ankerholz

RECORD

Cased _____ in., _____ ft.

Sand _____

Gas _____

Oil _____

Total Depth _____

PRODUCTION

1st 24 hrs. Nat. _____

1st 24 hrs. after shot _____

Gas _____ Cu. Ft.

Dry Hole _____

Abandoned _____

Date

JUN 6 1945

19

S. J. LEWIS

Scout