


Section 14 Township 19 Range 10 W

Well No. # 3 Helmke

Company J. Kornfeld

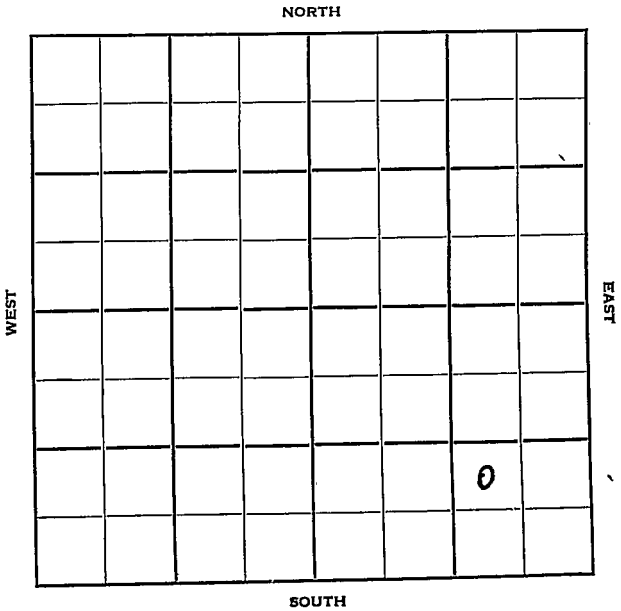

Sec. 14 Twp. 19 R. 10W

Well No. #3 Helmke Farm

J. Kornfeld Company

Lewis Contractor


_____ Ft. from N. Line

990 Ft. from S. Line

990 Ft. from E. Line

_____ Ft. from W. Line

NW SE SE

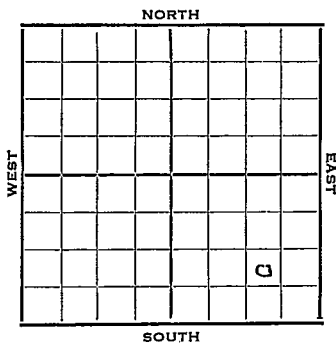

1952 Elev. 1737' REPORT

5/21 Spud 5-13-52
8" @ 186'

Drlg. 2820'

5/28 Spud 5-13-52

D&A TD 3301 8" @ 186'

Heeb. 2794' Tor. 2812

Br Li 2916 Lans. 2943

Cong. 3266

DST 3258-81 open 20 min. rec. 10' OCM

5% oil Arb. 3288 TD 3301'

D&A

ABANDONED

