

O. W. P. B.

KANSAS

FORM 51 5M BR1X


Rice County

Section 14 Township 19 Range 10W

Well No. #1 Southern

IscRN Bros.

Company ~~Keyes Drlg.~~

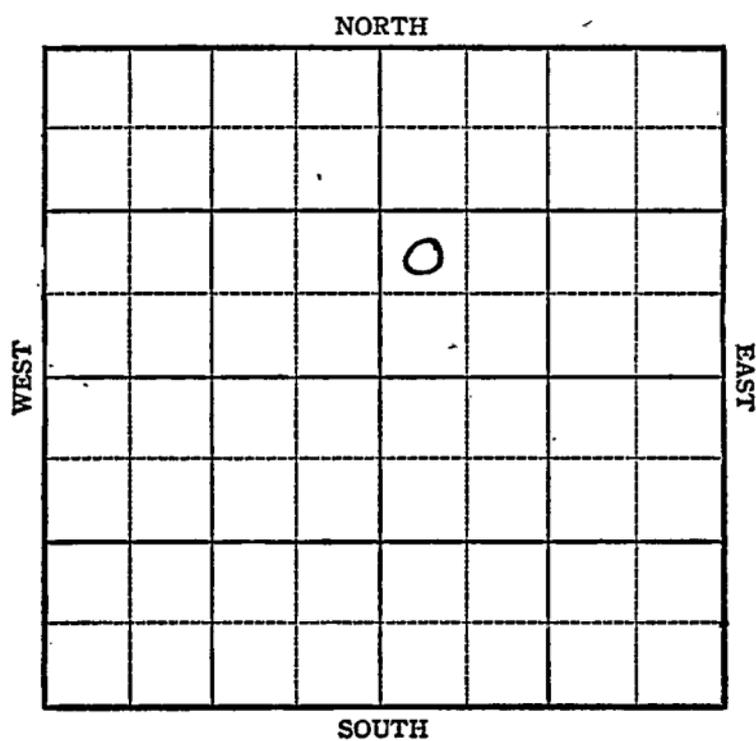

Sec. 14 Twp. 19 R. 10W

Well No. #1 Southern Farm

Isern Bros.
Keyes Drlg.

Company

Silica


_____ Ft. from N. Line

990 Ft. from S. Line

_____ Ft. from E. Line

330 Ft. from W. Line

NW SW NE Elev. 1746 SOUTH

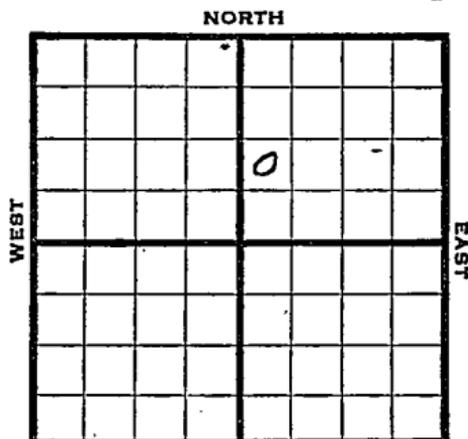

1944

R E P O R T

11/15	RUR
11/24	8" @ 150 Anhy 410 Drlg. 2794
11/29	Arb. 3256 -3260 TD 5" @ 3258 RUST
12/6	" " " " " " "
12/14	" " " " " " "
12/21	" " " " " " "
12/29	" " " " " " "
1945	
1/3	" " " " "
1/10	TD 3265 500 acid 2400' Oil
1/17	Swb 18 oil ph
1/26	" " " "
1/31	" " " "
2/7	" " " "
2/14	" " " "
2/21	Arb. 3256 5" @ 3258' 500 acid. TD 3265 Pump 357 Pot. Grav. 41.4

**COMPLETED
OVER**

1952
1/2

O. W. P. B.

Oil well TD 3181'

Lans. 2944' Arb. 3256'

(OTD 3265' 5" @ 3258'

PB 3181' 24/3142-48' 500 A

S/2 BOPH

Comp. 40 BOPD

**FIRST REPORT
COMPLETED.**

Pool Name SilicaMap No. 46 Sec. 14 Twp. 19 R. 10WWell No. 1 SouthernKeyes Drlg. CompanyFIRST REPORT Contractor

NW SW NE

SECTION PLAT

_____ Ft. from N. Line

99C Ft. from S. Line

_____ Ft. from E. Line

330 Ft. from W. LineRice

RECORD

Location _____

Cased _____ in., _____ ft.

Rig up _____

Sand _____

Drilling and Remarks:

Gas _____

R U R

Oil _____

Total Depth _____

PRODUCTION

1st 24 hrs. Nat. _____

1st 24 hrs. after shot _____

Gas _____ Cu. Ft.

Dry Hole _____

Abandoned _____

Date

NOV 15 1944 19

S. J. LEWIS Scout

Misc. Small Maps	<i>Leind</i>
Cards	<i>Atty L</i>
Tracing	<i>OTL</i>
Francis Map	<input checked="" type="checkbox"/>
Scarborough Map	<i>Leind</i>
Moody Map	<i>ML</i>
Coological Dept.	
Moody Plat Book	

Misc Small Maps	LR
Cards	Peitip
Tracing	LR
France-Map	✓
Scarborough Map	LR
Pierce Map	LR
Crological Dept.	
France Flat Book	


County Rice State Kansas

Sec. 14 (Blk. Twp.) 19 (Sur. Rge.) 10W Map No.

Operator Isern Bros.

Well No. 1 Farm Southern

Elev. _____ Location NW SW NE

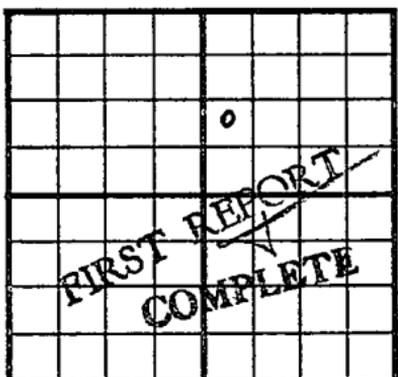

990 Ft. From S Line NE

330 Ft. From W Line Quarter

1st. Report JAN 2 1952

Completion JAN 2 1952

Remarks O.W.P.B.

Spudding Date _____

Drlg. Data Oil well TD 3181

Lans. 2944 Arb. 3256 OTD 3265

5" @ 3258 PB 3181 24/ 3142-48 500 A

S/ 2 boph Comp. 40 bopd

Scout Cards

Land Small Map

Land Wall Map

Tracings

France Map

Pierce Map

Misc.

JAN 3 1952

Dir. Data