


Mc Pherson

Form 51-5M-5-34-Palace
Map No. 14 Sec. 19 Twp. 2W
Well No. 4-13 Shellen Farm
Shell Pt. Company

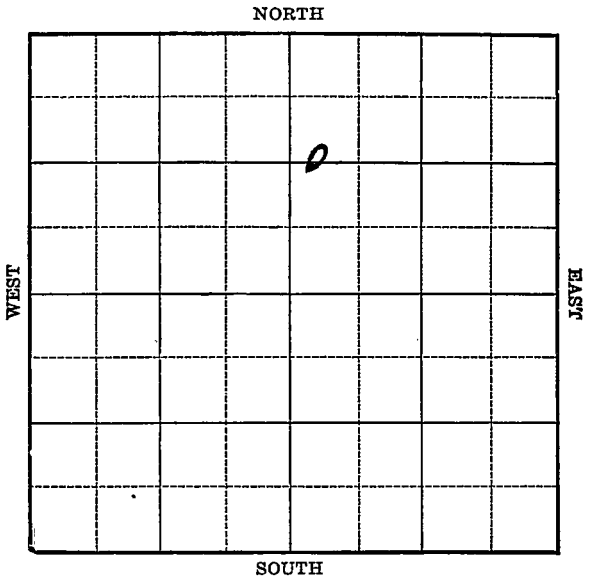

Location _____
Drilling Remarks _____

Rig Up _____
Drilling Remarks _____

RECORD

Cased _____ in. _____ ft.
Sand _____
Gas _____
Oil _____
Total Depth _____

PRODUCTION

1st 24 hrs. Nat. _____
1st 24 hrs. after shot _____
Gas _____ cu. ft. _____
Dry Hole _____
Abandoned _____

McPherson


Map No. KANSAS Sec. 14 Twp. 19 R. 2W
Well No. 4-B Kiffen Farm
Shell Pit. Company

1314 Ft. from N. Line

_____ Ft. from S. Line

_____ Ft. from E. Line

330 Ft. from W. Line

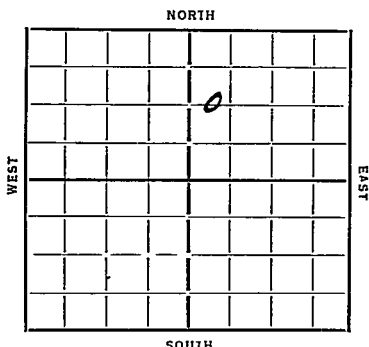

Date 1924

REPORT

12/19 Location
12/27 13" 166 WOC
1/3/31 Dly 1631
1/10 " 2935 T Chert 2879
1/17 7" 3349 Rust
1/24 Dly cement
1/31 Viola 3352 T 7 3355 1/2
150' oil 7 oil 0.5W 12 hrs.
1000 acid
2/6 Viola 3352 T 7 3355 1/2
1000 acid 453 oil 100 Water.

COMPLETED

Map No. 43 Sec. 14 Twp. 19 R. 2WWell No. HB-ZipfenShell pit Company

Contractor

FIRST REPORTS1314 Ft. from N. Line

Ft. from S. Line

Ft. from E. Line

330 Ft. from W. Line**SECTION PLAT**

		o	

Location ☒

Rig up

Drilling and Remarks:

RECORD

Cased.....in.,ft.

Sand.....

Gas.....

Oil.....

Total Depth.....

PRODUCTION

1st 24 hrs. Nat.....

1st 24 hrs. after shot.....

Gas.....Cu. Ft.

Dry Hole.....

Abandoned.....

Date

ORVAL MANNSCHECK12-19-34 192.....Scout

Map No. 43 Sec. 14 Twp. 19 R. 2WWell No. 4B-GriffinShell pit Company

Contractor

COMPLETED1314 Ft. from N. Line

Ft. from S. Line

Ft. from E. Line

330 Ft. from W. Line

SECTION PLAT

		0	
	.		
	.		

Location

Rig up

Drilling and Remarks:

1000 acid453 oil100 water

RECORD

Cased _____ in., _____ ft.

Sand Viola 3352

Gas _____

Oil _____

Total Depth 3355 1/2

PRODUCTION

1st 24 hrs. Nat. _____

1st 24 hrs. after shot _____

Gas _____ Cu. Ft.

Dry Hole _____

Abandoned _____

Date

2-6-35 192

ORVAL MANNSCHRECK

Scout