


McPherson

Form 51-5M-11-31-Palace

Map No. **KANSAS** Sec. 14 Twp. 19 R. 2 W

Well No. 4 Hidden Farm
Shell Pet. Company

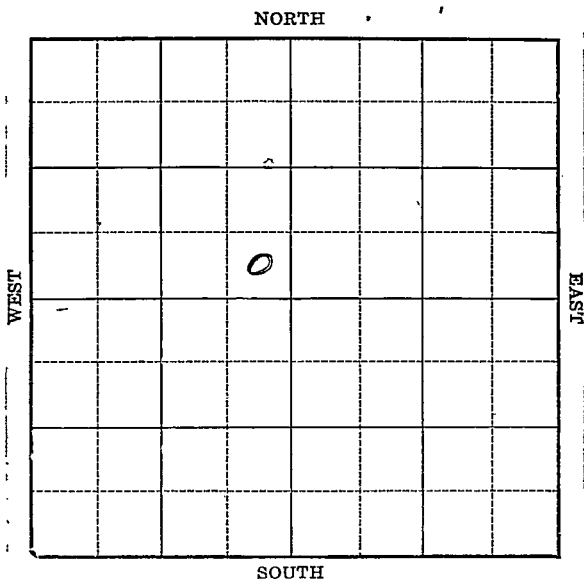

Location _____

Drilling Remarks _____

RECORD

Cased _____ in. _____ ft.

Sand _____

Gas _____

Oil _____

Total Depth _____

Rig Up _____

Drilling Remarks _____

PRODUCTION

1st 24 hrs. Nat. _____

1st 24 hrs. after shot _____

Gas _____ cu. ft.

Dry Hole _____

Abandoned _____


Map No. **KANSAS** Sec. 14 Twp 19 R. 2W
Well No. 4 Hidden Farm
Shell Pet. Company

 Ft. from N. Line

315 Ft. from S. Line

330 Ft. from E. Line

 Ft. from W. Line

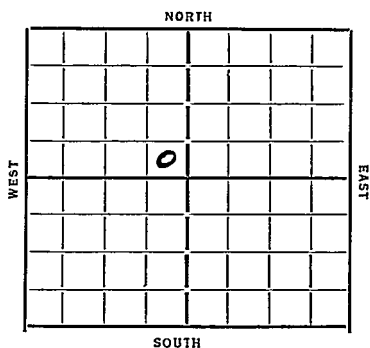

Date 1924

REPORT -

5/16 Location
5/26 —
5/31 R 22
6/7 dly 1830 13" 184
6/14 sd 2515
6/21 —
6/28 TC 2895 7" 3360 Rust
7/5 TV 3364 5.0" 3367 TD 3369
275' oil
7/12 1000 acid
7/18 Viola 3364 TD 3369
1000 acid 733 Bbls oil

COMPLETED

McPherson

Form 26 M. Rks. 2-29

KANSAS

Map No. 43 Sec. 14 Twp. 19 R. 2W

Well No. 4 - Kiffin

Shell pet

Company

Contractor

FIRST REPORT

SECTION PLAT

	0		

_____ Ft. from N. Line

315 Ft. from S. Line

330 Ft. from E. Line

_____ Ft. from W. Line

Location ✓

Rig up _____

Drilling and Remarks:

RECORD

Cased _____ in., _____ ft.

Sand _____

Gas _____

Oil _____

Total Depth _____

PRODUCTION

1st 24 hrs. Nat. _____

1st 24 hrs. after shot _____

Gas _____ Cu. Ft.

Dry Hole _____

Abandoned _____

Date

5-16-31 19

CPVAL MANNSCHECK

Scout

Map No. 43 Sec. 14 Twp. 19 R. 2W

Well No. 4 - Riffen

Shell pet. Company _____

Contractor _____

COMPLETED

SECTION PLAT

	0		

_____ Ft. from N. Line

315 Ft. from S. Line

330 Ft. from E. Line

_____ Ft. from W. Line

Location _____

Rig up _____

Drilling and Remarks:

1000 acid.

733 bbls
oil.

RECORD

Cased _____ in., _____ ft.

Sand Viola 3364

Gas _____

Oil _____

Total Depth 3369

PRODUCTION

1st. 24 hrs. Nat. _____

1st 24 hrs. after shot _____

Gas _____ Cu. Ft.

Dry Hole _____

Abandoned _____

Date

7-18-34 19

ORVAL MANNSCHRECK

Scout